

MISSISSIPPI DEPARTMENT OF NATURAL RESOURCES

Bureau of Land and Water Resources

Southport Mall

P.O. Box 10631

Jackson, Mississippi 39209 **CODED**

WATER WELL DRILLERS LOG

WILKINSON  
M 16  
11-22-81

11-22 1981 St Eastern Drill & Const. Wilkenson  
date well completed firm name county well located

LANDOWNER:	description of formations encountered	from	to
<u>Radzwinitz Operating</u> <u>Natches</u> (mailing address)	<u>top soil</u>	<u>0</u>	<u>10</u>
	<u>sand</u>	<u>10</u>	<u>110</u>
	<u>quartz</u>	<u>110</u>	<u>470</u>
	<u>sand</u>	<u>470</u>	<u>520</u>
WELL LOCATION: <u>2</u> sec. <u>27</u> T. <u>X</u> N. <u>5</u> R. <u>2</u> E. <u>W</u> <u>2</u> miles <u>SW</u> of <u>Woodville</u> (distance) (direction) (nearest town)	<u>Fr SW 1/4 Cor Sec. 28 go W 1/4</u> <u>alg 1/4 between Sec. 27 &amp; 38</u>		
WELL PURPOSE: (home, irrigation, municipal, industrial)	<u>For 884' H S 1/4 &amp; RA 535'</u> <u>to loc Sec. 38</u>		
WELL COMPLETION DATA:			
(1) diameter (inches) <u>3"</u>			
(2) total depth (feet) <u>520'</u>	<u>Stackitt #2</u>		
(3) static water level (feet) <u>200</u> <sup>below</sup> <sub>above</sub> top of ground.			
(4) casing <u>Blk.</u> <u>500'</u> (material) (depth)			
<u>3"</u> (size) If telescope see back.			
(5) screen <u>20'</u> <u>500'</u> (length) (depth to top)			
<u>3"</u> <u>slotted pipe</u> (size) (material)			
(6) pump <u>50</u> (HP) (yield gpm)			
<u>elec.</u> (type power)			
(7) electric log <u>no</u> (yes or no)			
(organization running log)			
(8) how well bottom plugged <u>weird plug</u>			
DRILLERS REMARKS:			

**CODED**


DEPT. OF NATURAL RESOURCES  
BUREAU OF LAND & WATER RESOURCES

DEC - 3 1981

**RECEIVED**

If well telescopes please  
sketch and show depths.

GROUND LEVEL

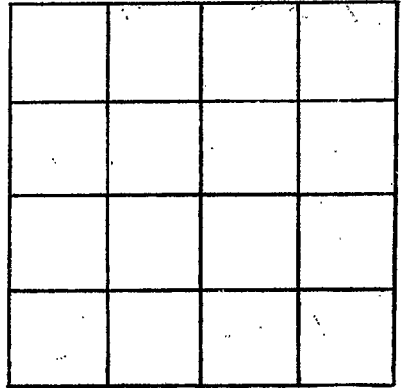

SECTION \_\_\_\_\_

Please indicate well location X.

ADDITIONAL INFORMATION

If more than one screen,  
show locations of each on sketch.