

MISSISSIPPI DEPARTMENT OF NATURAL RESOURCES

Bureau of Land and Water Resources

Southport Mall

P.O. Box 10631

Jackson, Mississippi 39209

WATER WELL DRILLERS LOG

CODED

M17
 Wilkinson
 8-16-83

8-16-83
 date well completed

Rayson Dilling & Co. Inc.
 firm name

Wilkinson
 county well located

LANDOWNER:
 AGCO Producing
 Vatchez Miss.
 (mailing address)

description of formations encountered	from	to
Top Soil	0	4
Chalk	50	
Sand	51	61
Chalk	62	280
Sand	281	390
Chalk & Shale	391	600

WELL LOCATION:
 sec. 10 T 8 N S R 2 E W
 (distance) (direction) (nearest town)

WELL PURPOSE:
 (home, irrigation, municipal, industrial)

WELL COMPLETION DATA:

(1) diameter (inches) 3"

(2) total depth (feet) 390'

(3) static water level (feet) 150' below above top of ground

(4) casing Blk 390' (material) (depth)
3" (size) if telescope see back.

(5) screen 20' 310' (length) (depth to top)
3" (size) dotted pipe (material)

(6) pump — 50 GPM (HP) (yield gpm)
 (type power)

(7) electric log No (yes or no)

350' N + 2063' E of SW / COY S10-2N-2W

Leak #1

(8) how well bottom plugged Wood Plug
 (organization running log)

DRILLERS REMARKS:


DEPT. OF NATURAL RESOURCES
 BUREAU OF LAND & WATER RESOURCES

SEP 27 1983

RECEIVED

If well telescopes please sketch and show depths.

GROUND LEVEL

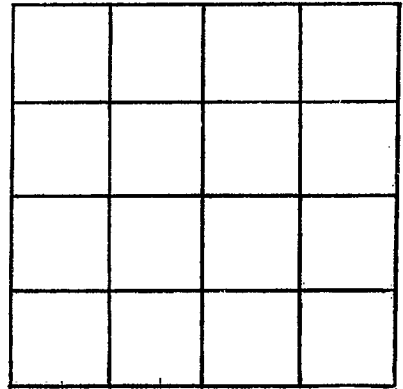

SECTION _____

Please indicate well location X.

ADDITIONAL INFORMATION

If more than one screen,
show locations of each on sketch.