

MISSISSIPPI DEPARTMENT OF NATURAL RESOURCES

Bureau of Land and Water Resources

Southport Mall

P.O. Box 10631

Jackson, Mississippi 39209

WATER WELL DRILLERS LOG

CODED

WILKINSON

M 18

8/2 1984 date well completed

Rayborn Drilling firm name

Wilkinson county well located

LANDOWNER:

Energy Drilling
Natchez, MS 39120
(mailing address)

description of formations encountered

from to

Top Soil	0	3
Chalk	4	25
Sand	26	50
Chalk	51	290
Sand	291	330
Chalk	331	398
Sand	399	418
Chalk	419	430
Sand	431	450
Row - Timber #1		

WELL LOCATION:

sec 25 T 20 N R 2 E
3 miles NW of Woodville
(distance) (direction) (nearest town)

WELL PURPOSE: oil field
(home, irrigation, municipal, industrial)

WELL COMPLETION DATA:

- (1) diameter (inches) 4"
- (2) total depth (feet) 450'
- (3) static water level (feet) 220' below top of ground.
- (4) casing blk pipe 430' (material) (depth)
4" (size) if telescope see back.
- (5) screen 20' 430' (length) (depth to top)
4" (size) slotted pipe (material)
- (6) pump (HP) 50 (yield gpm)
(type power)
- (7) electric log no (yes or no)
(organization running log)
- (8) how well bottom plugged wood

DEPT. OF NATURAL RESOURCES
BUREAU OF LAND & WATER RESOURCES


NOV 1 1984

RECEIVED

DRILLERS REMARKS:

If well telescopes please sketch and show depths.

GROUND LEVEL

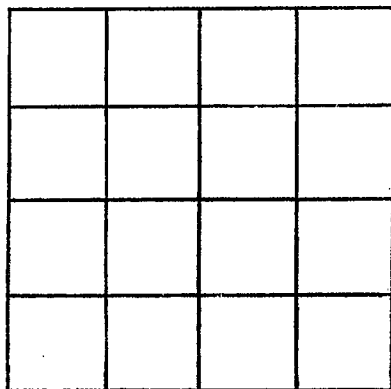

SECTION _____

Please indicate well location X.

ADDITIONAL INFORMATION

If more than one screen,
show locations of each on sketch.