

MISSISSIPPI DEPARTMENT OF NATURAL RESOURCES

Bureau of Land and Water Resources

Southport Mall

P.O. Box 10631

Jackson, Mississippi 39209

WATER WELL DRILLERS LOG

CODED

WILKINSON
M 19

8/29/84 date well completed

Raybon Drilling firm name

Wilkinson county well located

Landowner: Irene Stewart

Woodville, MS (mailing address)

description of formations encountered

Top Soil

from

to

0 10

sand

11 40

Gumbo

41 80

Gravel

81 130

WELL LOCATION:

sec. 35 T. 20 N. R. 2 E S. 1 W. 1/2 miles west of Woodville (distance) (direction) (nearest town)

WELL PURPOSE: private (home, irrigation, municipal, industrial)

CODED

WELL COMPLETION DATA:


- (1) diameter (inches) 4"
- (2) total depth (feet) 130'
- (3) static water level (feet) 100' below top of ground.
- (4) casing PVC pipe, 110' (material) (depth) 4" (size) If telescope see back.
- (5) screen 20' 110' (length) (depth to top) 4" (size) PVC slotted pipe (material)
- (6) pump 3/4 14 (HP) (yield gpm) electric (type power)
- (7) electric log no (yes or no)
- (organization running log)
- (8) how well bottom plugged wood

DRILLERS REMARKS:

MISSISSIPPI DEPARTMENT OF NATURAL RESOURCES
BUREAU OF LAND AND WATER RESOURCES
NOV 11 1984

If well telescopes please sketch and show depths.

GROUND LEVEL

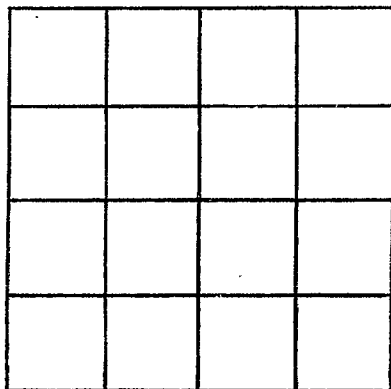

SECTION _____

Please indicate well location X.

ADDITIONAL INFORMATION

If more than one screen, show locations of each on sketch.