	1 State Well J	Renort	
County: Wilkinson	Part 1	-	For Office Use Only:
Permit #:	Mississippi Department of E		Aquifer:
	Office of Land and W P.O. Box 10		Well #: <u>M-25</u>
Driller: Gary Rayborn	Jackson, MS 392	289-0631	L. S. Elevation:
Date drilling completed: 62305	(601)961-5210 (601)354-6938 (fax)		E-log #:
State Law requires that this rep		er in detail and filed w	ith the Department with
30 days of completion of drilling Well Owner Inform	g of the well.	Wel	Location
Owner Name Gordon			_" Longitude:°'
Mailing Address: <u>7120 I+</u>	hace St Meth	nod of Lat/Long (circle or	e): Conventional Survey,
		USGS quad, Hand-held	GPS, Survey-grade GPS
Metairie LA	70003	_1414 Sec_11	
)	ate Zip Code Dist	ance Direction	Nearest Town
Telephone No. (504) 462 - 3	850	Miles W	of Woodu le
	Well Data		
Purpose of Well (circle one Home In	ductrial Dublic Supply Irrig	ration Fish Culture	Other:
•			
Date well drilling started: 6-23	Date well dr	illing completed:	1-23-05
If flowing, method of flow regulation: Va	alve Other (describ	e)	
Static Water Level:feet a	bove or below (circle one) land su	urface Date measured:	6-23.05
Hole depth: Well de		ell grouted to a depth of _	feet
Type of grout (circle one): Cement	Bentonite Mix		
Casing length: <u><b>95</b></u> feet Cas	ing diameter: <u>411</u> incl	hes Type of casing: _	PVC
0 0			
	een diameter: <u>4</u> inc	nes Type of screen:	
Screen length: <b><u>20</u></b> feet Scr			
Screen length: <u>70</u> feet Scr Screen slot size: <u>1010</u> inches	Setting depth: From	<b>5</b> feet to <b>1</b>	15feet
Screen length: <b>20</b> feet Scr	Setting depth: From <b>9</b> . Gravel packed Underreame	feet to d Telescoped Oper	feet feet hole Natural Developme
Screen length: <b>20</b> feet Scr Screen slot size: <b>1010</b> inches Type of completion (circle all applicable)	Setting depth: From : Gravel packed Underreame Other (describe):	feet to	feet feet hole Natural Developme
Screen length: <b>20</b> feet Scr Screen slot size: <u>1010</u> inches Type of completion (circle all applicable) Top of lap pipe or reduction in casing:	Setting depth: From : Gravel packed Underreame Other (describe): feet. If telescop	feet to d Telescoped Oper ped or more than one scr	feet hole Natural Developme
Screen length: <b>20</b> feet Scr Screen slot size: <b>010</b> inches Type of completion (circle all applicable)	Setting depth: From : Gravel packed Underreame Other (describe): feet. If telescop	feet to d Telescoped Oper ped or more than one scr	feet hole Natural Developme
Screen length: <b>20</b> feet Scr Screen slot size: <u>1010</u> inches Type of completion (circle all applicable) Top of lap pipe or reduction in casing: <u>1000</u> Logs run (circle all applicable): No log r	Setting depth: From : Gravel packed Underreame Other (describe): feet. If telescop In Electric Gamma Ray Der	feet to d Telescoped Oper or more than one scr asity Sonic Neutron	feet hole Natural Developme reen, describe on back of pag Other:
Screen length: <b>20</b> feet Scr Screen slot size: <b>1010</b> inches Type of completion (circle all applicable) Top of lap pipe or reduction in casing: <b>1</b> Logs run (circle all applicable): No log r Name of organization running log(s): <b>1</b> <b>I certify that the well was drilled, const</b>	Setting depth: From : Gravel packed Underreame Other (describe): feet. If telescop un Electric Gamma Ray Der ructed, and completed in accord	feet to d Telescoped Oper oed or more than one scr asity Sonic Neutron	feet hole Natural Developme reen, describe on back of pag Other: requirements of the Mississ
Screen length: <b>20</b> feet Scr Screen slot size: <u>1010</u> inches Type of completion (circle all applicable) Top of lap pipe or reduction in casing: <u>1000</u> Logs run (circle all applicable): No log r	Setting depth: From : Gravel packed Underreame Other (describe): feet. If telescop un Electric Gamma Ray Der ructed, and completed in accord	feet to d Telescoped Oper oed or more than one scr asity Sonic Neutron	feet hole Natural Developme reen, describe on back of pag Other: requirements of the Mississ
Screen length: <u>20</u> feet Scr Screen slot size: <u>1010</u> inches Type of completion (circle all applicable) Top of lap pipe or reduction in casing: <u>1000</u> Logs run (circle all applicable): No log r Name of organization running log(s): <u>1000</u> I certify that the well was drilled, const Department of Environmental Quality	Setting depth: From : Gravel packed Underreame Other (describe): feet. If telescop In Electric Gamma Ray Der ructed, and completed in accord and/or the Mississippi Departme	feet to d Telescoped Oper oed or more than one scr asity Sonic Neutron	feet hole Natural Developme reen, describe on back of pag Other: requirements of the Mississ
Screen length: <u>20</u> feet Scr Screen slot size: <u>1010</u> inches Type of completion (circle all applicable) Top of lap pipe or reduction in casing: <u>1000</u> Logs run (circle all applicable): No log r Name of organization running log(s): <u>1000</u> I certify that the well was drilled, const Department of Environmental Quality Rayborn Drilling To	Setting depth: From : Gravel packed Underreame Other (describe): feet. If telescop In Electric Gamma Ray Der ructed, and completed in accord and/or the Mississippi Department C	feet to d Telescoped Oper ored or more than one scr asity Sonic Neutron lance with all applicable ent of Health regulation	Ising feet         hole       Natural Developme         reen, describe on back of page         Other:
Screen length: <u><b>20</b></u> feet Scr Screen slot size: <u><b>010</b></u> inches Type of completion (circle all applicable) Top of lap pipe or reduction in casing: <u></u> Logs run (circle all applicable): No log r Name of organization running log(s): <u></u> I certify that the well was drilled, const Department of Environmental Quality	Setting depth: From : Gravel packed Underreame Other (describe): feet. If telescop In Electric Gamma Ray Der ructed, and completed in accord and/or the Mississippi Department C	feet to d Telescoped Oper ored or more than one scr asity Sonic Neutron lance with all applicable ent of Health regulation	feet hole Natural Developme eeen, describe on back of pag Other: requirements of the Mississ and state laws. f Water Well Contractor
Screen length: <u>20</u> feet Scr Screen slot size: <u>1010</u> inches Type of completion (circle all applicable) Top of lap pipe or reduction in casing: <u>1000</u> Logs run (circle all applicable): No log r Name of organization running log(s): <u>1000</u> I certify that the well was drilled, const Department of Environmental Quality Rayborn Drilling Tr	Setting depth: From : Gravel packed Underreame Other (describe): feet. If telescop In Electric Gamma Ray Der ructed, and completed in accord and/or the Mississippi Department C	feet to d Telescoped Oper ored or more than one scr asity Sonic Neutron lance with all applicable ent of Health regulation	Ising feet         hole       Natural Developme         reen, describe on back of page         Other:
Screen length: <u>20</u> feet Scr Screen slot size: <u>1010</u> inches Type of completion (circle all applicable) Top of lap pipe or reduction in casing: <u>1000</u> Logs run (circle all applicable): No log r Name of organization running log(s): <u>1000</u> I certify that the well was drilled, const Department of Environmental Quality Rayborn Drilling Tr	Setting depth: From : Gravel packed Underreame Other (describe): feet. If telescop In Electric Gamma Ray Der ructed, and completed in accord and/or the Mississippi Department C	feet to d Telescoped Oper ored or more than one scr asity Sonic Neutron lance with all applicable ent of Health regulation	feet hole Natural Developme eeen, describe on back of pag Other: requirements of the Mississ and state laws. f Water Well Contractor

.

Mailing Address: <u>7120 THacaSt</u> <u>Metairie LA 70003</u> <u>City State Zip Code</u> <u>Distance</u> <u>Telephone No. (504) 462 - 3850</u> <u>Pump Type</u> <u>Circle one</u>	-0631 Well #: <u>//</u>		
installation of pump.         Well Owner Information         Owner Name:       Gordon Botts         Mailing Address:       TI20 Ithaca St         Method       Method         Mailing Address:       TI20 Ithaca St       Method         Method       Method         Method       Distance         Telephone No.       Distance         Pump Type       Circle one         Air Lift       Jet       Diesel	Well Location         le:       Longitude:         l of Lat/Long (circle one): Conventional Survey,         USGS quad, Hand-held GPS, Survey-grade GPS         14       14 Sec 1 1 Twn 2 N Rng 2 W         2e       Direction         Direction       Nearest Town        Miles       W of Wooduille         Power Type         Circle one		
Dwner Name: <u>Gordon Botts</u> Mailing Address: <u>TI20 Ithaca St</u> <u>Method</u> <u>Metairie LA 70003</u> City State Zip Code Distance <u>Jelephone No. (504) 462 - 3850</u> <u>Air Lift</u> Jet <u>Submersible</u> Diesel	le:Longitude: l of Lat/Long (circle one): Conventional Survey, USGS quad, Hand-held GPS, Survey-grade GPS 1414 Sec_11 Twn 2N Rng 2W re Direction Nearest Town Miles Wof Wooduille Power Type Circle one		
Mailing Address: <u>Method</u> <u>Metairie LA 70003</u> City State Zip Code Distance <u>Air Lift</u> Jet <u>Submersible</u> Diesel	I of Lat/Long (circle one): Conventional Survey,         USGS quad, Hand-held GPS, Survey-grade GPS         14       14 Sec 11 Twn 2N Rng 2W         2e       Direction         Miles       V       of Wooduille         Power Type         Circle one		
Metairie LA       70003         City       State       Zip Code         Distance       Distance         Felephone No. (504)       462 - 3850       3         Pump Type Circle one         Air Lift       Jet       Submersible       Diesel	USGS quad, Hand-held GPS, Survey-grade GPS 14 14 Sec Twn RngW 2e Direction Nearest Town Miles ofWooduille Power Type Circle one		
City     State     Zip Code       Distance       Telephone No. (504)     462 - 3850       Air Lift       Jet       Submersible   Dissel	<u>14</u> <u>14 Sec <u>11</u> Twn <u>2</u> <u>W</u> Rng <u>2</u> <u>W</u> Direction Nearest Town <u>Miles W of Wooduille</u> <u>Power Type</u> Circle one</u>		
City     State     Zip Code       Distance       Telephone No. (504)     462 - 3850       Air Lift       Jet       Submersible   Dissel	Direction       Nearest Town         Miles       W       of       Wooduille         Power Type       Circle one		
Pump Type       Circle one       Air Lift       Jet       Submersible	Power Type Circle one		
Circle one Air Lift Jet Submersible Diesel	Circle one		
Air Lift Jet Submersible Diesel			
	Engine Gasoline Engine Natural Gas		
Bucket Piston Turbine Electric			
continuitation into any interest of the second se	aill Other (specify):		
	Power Rating of Motor: <u>Ihp</u>		
	Setting Depth:feet Number of Stages:		
	Method of Measuring Water Level		
Pump Test Data Date Well Tested: 6-23-05	Circle one		
Date Well Tested: QOFeet Below Land Surface	Electric Measuring Line Steel Tape		
Other	Other (specify):		
Pumping Water Level (B):Feet Below Land Surface	wine well many abut in bands		
	wing well, measured shut in head:feet		
	ielded GPM with a drawdown of		
Duration of Pump Test (minimum 4 hours):hours	feet afterhours of pumping		
I HEREBY CERTIFY that the above statements are true to the best of my known	owledge.		

يد ب

> JUL 2 0 2005 BY: OLWR

If well telescopes please sketch below and show depths.


## Ground Level

έ

	Description of Formations Encountered	From	То
—  -	Clay	0	40
	Grave	40	80
	sand	80	IIS .
			┨────
			<u> </u>
			1
	· · · · · · · · · · · · · · · · · · ·		
			+
			<u> </u>
			<u> </u>
			1
	····		·
			<u> </u>

M-25

If more than one screen, show location of each on sketch

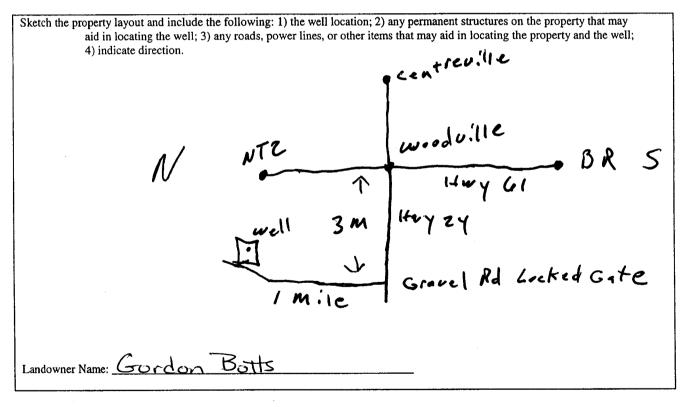

Signature of Well Contractor

JUL 2 0 2005 BY: OLWR