

Wilkinson  
 M  
 6/11/76

MISSISSIPPI  
 BOARD OF WATER COMMISSIONERS  
 416 North State Street  
 Jackson, Mississippi 39201

WATER WELL DRILLERS LOG

June 11 1976 <sup>14E</sup> Reverwell Inc Wilkinson  
 date well completed firm name county well located

LANDOWNER: Charles Langston (owner)  
Box Woodville  
 (mailing address)

description of formations encountered	from	to
clay	0	12
blue clay	12	210
fine sand	210	260
Coarse sand	260	282

WELL LOCATION:  
 sec. 3 T. 2 N. R. 2 E  
4 miles North Woodville  
 (distance) (direction) (nearest town)

WELL PURPOSE: house  
 (home, irrigation, municipal, industrial)

- WELL COMPLETION DATA:
- (1) diameter (inches) 2"
  - (2) total depth (feet) 282
  - (3) static water level (feet) 140 below above top of ground.
  - (4) casing Steel Cast Iron  
 (material) (depth)
  - (size) if telescope see back.
  - (5) screen 5' 277  
 (length) (depth to top)
  - (size) (material) 1 1/2" Steel
  - (6) pump by others  
 (HP) (yield gpm)
  - (type power) elect
  - (7) electric log no  
 (yes or no)
  - (organization running log)

(8) how well bottom plugged no


DRILLERS REMARKS:  
Screen plug

RECEIVED  
 OCT - 7 1976

MISS. BR. OF WATER COMMISSIONERS

If well telescopes please sketch and show depths.

GROUND LEVEL

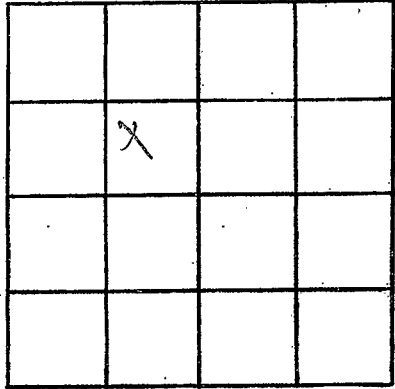

SECTION 3

Please indicate well location X.

ADDITIONAL INFORMATION

If more than one screen, show locations of each on sketch.