

WILKINSON
 M
 2-8-77

MISSISSIPPI
 BOARD OF WATER COMMISSIONERS
 416 North State Street
 Jackson, Mississippi 39201

WATER WELL DRILLERS LOG

2-8 146 27 Rayborn Drilling & Const. Co. Wilkinson
 date well completed firm name county well located

LANDOWNER:
 G.M. Smith
 Woodville, Miss.
 (mailing address)

description of formations encountered	from	to
Top Soil	0	2
Clay	2	95
fine sand	95	130
grey clay	130	310
Shale	210	240

WELL LOCATION:
 sec. 8 T. 2 N. R. 2 E
 S W
 3 miles NW of Woodville
 (distance) (direction) (nearest town)

WELL PURPOSE: Home
 (home, irrigation, municipal, industrial)

- WELL COMPLETION DATA:
- (1) diameter (inches) 3"
 - (2) total depth (feet) 240'
 - (3) static water level (feet) 117' below top of ground.
 - (4) casing galv. 233'
 (material) (depth)
 2" If telescope see back.
 (size)
 - (5) screen 5' 233'
 (length) (depth to top)
 2" "55"
 (size) (material)
 - (6) pump 2 66 gpm
 (HP) (yield gpm)
 elec
 (type power)
 - (7) electric log no
 (yes or no)


(organization running log)
 (8) how well bottom plugged wood plug

DRILLERS REMARKS:

RECEIVED
 FEB 10 1977

If well telescopes please sketch and show depths.

GROUND LEVEL

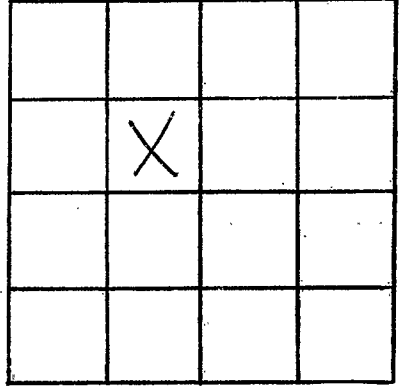

SECTION 8

Please indicate well location X.

ADDITIONAL INFORMATION

If more than one screen, show locations of each on sketch.