

MISSISSIPPI DEPARTMENT OF NATURAL RESOURCES

Bureau of Land and Water Resources

Southport Mall

P.O. Box 10631

Jackson, Mississippi 39209

WATER WELL DRILLERS LOG

WILKINSON
M 2003
1-11-80

Jan 11 1980 Recess well for Wilkinson
 date well completed firm name county well located

LANDOWNER:	description of formations encountered	from	to
<u>Lucille Alexander</u>			
<u>RT-1 60433</u> (mailing address)	<u>brown clay</u>	<u>0</u>	<u>12</u>
<u>Woodville</u>	<u>white chalk</u>	<u>12</u>	<u>60</u>
	<u>blue chalk</u>	<u>60</u>	<u>145</u>
	<u>coarse sand</u>	<u>145</u>	<u>173</u>
WELL LOCATION:			
sec. <u>15</u> T. <u>2</u> N R. <u>2</u> W			
<u>1 1/2</u> miles <u>north</u> of <u>Woodville</u>			
(distance) (direction) (nearest town)			
WELL PURPOSE: <u>new house</u>			
(home, irrigation, municipal, industrial)			
WELL COMPLETION DATA:			
(1) diameter (inches) <u>4"</u>			
(2) total depth (feet) <u>173</u>			
(3) static water level (feet) <u>130'</u> below ^{above} top of ground.			
(4) casing <u>plastic bottom</u>			
(material) (depth)			
(size) If telescope see back.			
(5) screen <u>10'</u> <u>163'</u>			
(length) (depth to top)			
<u>4"</u> <u>plastic</u>			
(size) (material)			
(6) pump <u>3 sub</u> <u>12</u>			
(HP) (yield gpm)			
<u>elect</u>			
(type power)			
(7) electric log <u>no</u>			
(yes or no)			
(organization running log)			
(8) how well bottom plugged <u>Backwash valve</u>			
DRILLERS REMARKS:			


DEPT. OF NATURAL RESOURCES
 BUREAU OF LAND & WATER RESOURCES

NOV 14 1980

RECEIVED

If well telescopes please sketch and show depths.

GROUND LEVEL

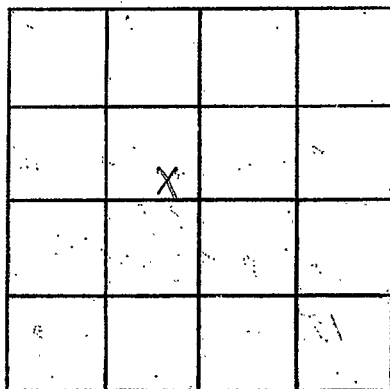

SECTION 15

Please indicate well location X.

ADDITIONAL INFORMATION

If more than one screen,
show locations of each on sketch.