

MISSISSIPPI DEPARTMENT OF NATURAL RESOURCES

Bureau of Land and Water Resources

Southport Mall

P.O. Box 10631

Jackson, Mississippi 39209

WATER WELL DRILLERS LOG

Wilkinson
M
2005

May 19 1982 Reuben Wilkin Wilkinson
 date well completed firm name county well located

LANDOWNER:	description of formations encountered	from	to
<u>William Holston</u> <u>Rt 4 Woodville</u> (mailing address)			
	<u>brown sand</u>	<u>5</u>	<u>65</u>
	<u>blue chalk</u>	<u>65</u>	<u>135</u>
	<u>sand (fine)</u>	<u>135</u>	<u>175</u>
	<u>sand & pebbles</u>	<u>175</u>	<u>185</u>
WELL LOCATION:			
sec. <u>13</u> T <u>2</u> N R <u>2</u> W			
<u>2</u> miles <u>north</u> of <u>Woodville</u>			
(distance) (direction) (nearest town)			
WELL PURPOSE: <u>Home</u>			
(home, irrigation, municipal, industrial)			
WELL COMPLETION DATA:			
(1) diameter (inches) <u>4"</u>			
(2) total depth (feet) <u>185</u>			
(3) static water level (feet) <u>95</u> below top of ground.			
(4) casing <u>plastic bottom</u>			
(material) (depth)			
(size) if telescope see back.			
(5) screen <u>5'</u> <u>180</u>			
(length) (depth to top)			
<u>4"</u> <u>plastic</u>			
(size) (material)			
(6) pump <u>3/4</u> <u>12</u>			
(HP) (yield gpm)			
<u>elect</u>			
(type power)			
(7) electric log <u>no</u>			
(yes or no)			
(organization running log)			
(8) how well bottom plugged <u>back wash</u>			
DRILLERS REMARKS:			


DEPT. OF NATURAL RESOURCES
 BUREAU OF LAND & WATER RESOURCES

NOV 16 1982

RECEIVED

If well telescopes please
sketch and show depths.

GROUND LEVEL

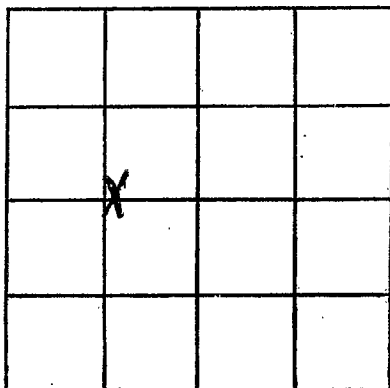

SECTION 13

Please indicate well location X.

ADDITIONAL INFORMATION

If more than one screen, . . .
show locations of each on sketch.