

MISSISSIPPI DEPARTMENT OF NATURAL RESOURCES

Bureau of Land and Water Resources

Southport Mall

P.O. Box 10631

Jackson, Mississippi 39209

WATER WELL DRILLERS LOG

M 2007

9/14/84 date well completed 1984 Raybon Drilling firm name Wilkinson county well located

LANDOWNER: G.M. Smith  
 Rt 1 Box 1835  
 Woodville, MS  
 (mailing address)

WELL LOCATION:  
 sec 5 T 2 N R 2 E  
 10 miles NW of Woodville  
 (distance) (direction) (nearest town)

WELL PURPOSE: private  
 (home, irrigation, municipal, industrial)

- WELL COMPLETION DATA:
- (1) diameter (inches) 4"
  - (2) total depth (feet) 257'
  - (3) static water level (feet) 125' below top of ground.
  - (4) casing PVC pipe, 237' (material) (depth)  
 4" (size) if telescope see back.
  - (5) screen 20', 237' (length) (depth to top)  
 4" (size) PVC slotted pipe (material)
  - (6) pump 3/4 (HP) 14 (yield gpm)  
 electric (type power)
  - (7) electric log NO (yes or no)
  - (organization running log)
  - (8) how well bottom plugged wood

description of formations encountered	from	to
Top Soil	0	20
Chalk	21	100
Sand	61	80
Chalk	81	105
Sand	106	120
Chalk	121	217
Sand	218	257


RECEIVED  
 JAN 24 1985

DRILLERS REMARKS:

Department of Natural Resources  
 Bureau of Land & Water Resources

If well telescopes please  
sketch and show depths.

GROUND LEVEL

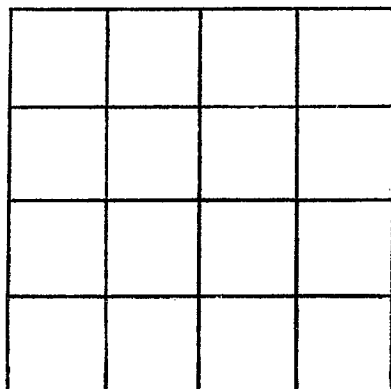

SECTION \_\_\_\_\_

Please indicate well location X.

ADDITIONAL INFORMATION

If more than one screen,  
show locations of each on sketch.