

Bureau of Land and Water Resources

Southport Mall

P.O. Box 10631

Jackson, Mississippi 39209

WATER WELL DRILLERS LOG

WILKINSON
M 2008

1-16 1987

RAYBORN DRILLING, INC.

Wilkinson

date well completed

firm name

county well located

LANDOWNER: Linda Smith

P.O. Box 92

Woodville MS 39669
(mailing address)

WELL LOCATION:

sec. 48 T 2 N R 2 E
S W
6 miles N of Woodville
(distance) (direction) (nearest town)

WELL PURPOSE: home
(home, irrigation, municipal, industrial)

WELL COMPLETION DATA:

- (1) diameter (inches) 4"
- (2) total depth (feet) 335'
- (3) static water level (feet) 150' ^{below} top of ground
- (4) casing Sch 40 PVC, 325' (material) (depth)
4" (size) If telescope see back.
- (5) screen 10' , 325' (length) (depth to top)
4" Slotted Sch 40 PVC (size) (material)
- (6) pump 1 (HP) 15 (yield gpm)
electric (type power)
- (7) electric log no (yes or no)
(organization running log)
- (8) how well bottom plugged Wood

description of formations encountered

from

to

Top Soil	0	4
Chalk	4	150
Sand	150	160
Shale	160	270
Sand	270	335

RECEIVED


JUN 24 1987

Department of Natural Resources
Bureau of Land & Water Resources

DRILLERS REMARKS:

If well telescopes please sketch and show depths.

GROUND LEVEL

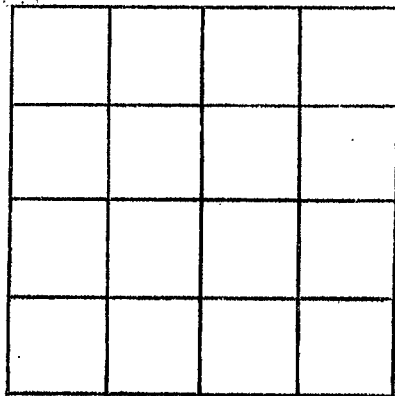

SECTION _____

Please indicate well location X.

ADDITIONAL INFORMATION

If more than one screen,
show locations of each on sketch.