

CODED

CODED

Wilkinson  
NI  
9-67

MISSISSIPPI  
BOARD OF WATER COMMISSIONERS  
416 North State Street  
Jackson, Mississippi 39201

WATER WELL DRILLERS LOG

9-8-1969 date well completed  
G Fitzgerald Water Well firm name  
Catoe county well located

LANDOWNER: HR. Humphrey  
Centerville Rt 1 Box 157  
(mailing address)


WELL LOCATION:  
sec 23 T 2 N R 1 E  
11 miles NW of Centerville  
(distance) (direction) (nearest town)

WELL PURPOSE: home  
(home, irrigation, municipal, industrial)

- WELL COMPLETION DATA:
- (1) diameter (inches) 4
  - (2) total depth (feet) 256
  - (3) static water level (feet) 180 below top of ground.
  - (4) casing plastic 250'  
(material) (depth)  
4" If telescope see back.  
(size)
  - (5) screen 6' 250'  
(length) (depth to top)  
4 plastic  
(size) (material)
  - (6) pump 3/4 hp 10  
(HP) (yield gpm)  
3/4 hp  
(type power)
  - (7) electric log No  
(yes or no)
  - (8) how well bottom plugged Wood peg

description of formations encountered	from	to
Red gravel	0	18
Red Sand	10	110
Sandy gravel	110	117
Red White Blue dr. bank	117	239
Coarse Sand	239	256
Chalk		28


CODED

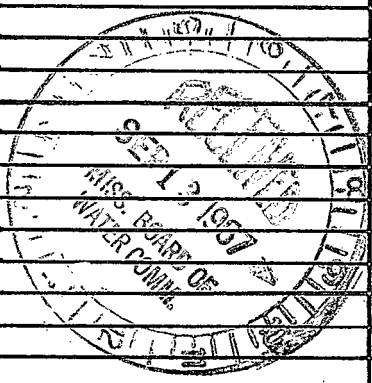

DRILLERS REMARKS:

If well telescopes please sketch and show depths.

GROUND LEVEL

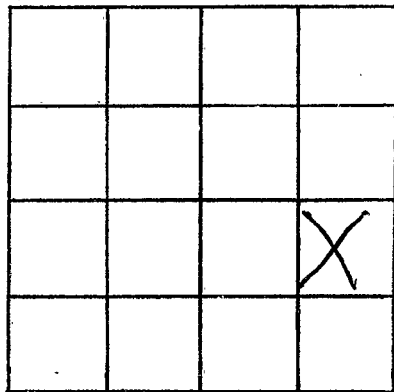

SECTION

23

Please indicate well location X.

ADDITIONAL INFORMATION

If more than one screen,  
show locations of each on sketch.