

Wilkinson
 N 4.
 11-15-69

MISSISSIPPI
 BOARD OF WATER COMMISSIONERS
 416 North State Street
 Jackson, Mississippi 39201

INDEXED

WATER WELL DRILLERS LOG

Nov-15 1969 date well completed
 Keenswell Drilling firm name
 Wilkinson county well located

LANDOWNER: Carl
 Truffenbahr
 Woodville
 (mailing address)

description of formations encountered	from	to
Red clay	0	15
Red fine sand	15	97
Hard white chalk	97	175
fine white sand	175	187
coarse white sand	187	200

WELL LOCATION:
 sec 32 T 20 N R 1 E
 3 miles E Woodville
 (distance) (direction) (nearest town)

WELL PURPOSE: Home
 (home, irrigation, municipal, industrial)

WELL COMPLETION DATA:

- (1) diameter (inches) 4"
- (2) total depth (feet) 200
- (3) static water level (feet) 95 below top of ground.
- (4) casing Plastic, Bottom
 (material) (depth)
- (5) screen 6' 194'
 (length) (depth to top)
 4" Plastic
 (size) (material)
- (6) pump 1/2 HP 12
 (HP) (yield gpm)
 220V
 (type power)
- (7) electric log No
 (yes or no)

(organization running log)


(8) how well bottom plugged
 woodchips

DRILLERS REMARKS:
 all 7" had
 well had

DEC 31 1969

If well telescopes please sketch and show depths.

GROUND LEVEL

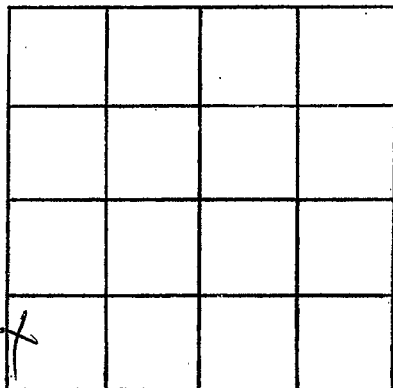

SECTION 32

Please indicate well location X.

ADDITIONAL INFORMATION

If more than one screen,
show locations of each on sketch.