

albert

Wilkinson
N 5
3-13-70

MISSISSIPPI  
BOARD OF WATER COMMISSIONERS  
416 North State Street  
Jackson, Mississippi 39201

CODED

WATER WELL DRILLERS LOG

3-13 1970 Primer water well Wilkinson  
 date well completed firm name county well located

LANDOWNER:  
Jimmy Fry  
Woodville, Miss.  
(mailing address)

description of formations encountered	from	to
<u>Top Soil</u>	<u>0</u>	<u>2</u>
<u>Clay</u>	<u>2</u>	<u>82</u>
<u>Sand</u>	<u>82</u>	<u>113</u>

WELL LOCATION:  
sec. 28 T 2 N R 1 E  
6 miles east of Woodville  
(distance) (direction) (nearest town)

WELL PURPOSE: Home  
(home, irrigation, municipal, industrial)

WELL COMPLETION DATA:

(1) diameter (inches) 2"

(2) total depth (feet) 113'

(3) static water level (feet) 84' below top of ground.

(4) casing Galv. 105'  
(material) (depth)  
2" if telescope see back.  
(size)

(5) screen 5' 105'  
(length) (depth to top)  
2" SS.  
(size) (material)

(6) pump 1 7  
(HP) (yield gpm)  
electric  
(type power)

(7) electric log no  
(yes or no)

(organization running log)

(8) how well bottom plugged reachley

CODED


DRILLERS REMARKS:

APR 9 1970

MISS. BD. OF WATER COMM.

If well telescopes please sketch and show depths.

GROUND LEVEL

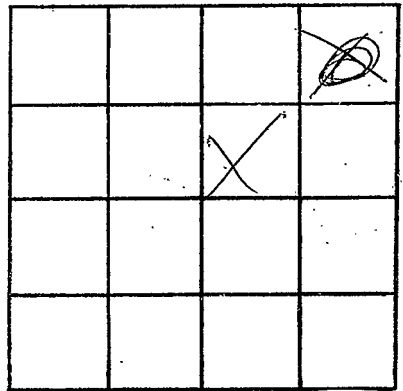

SECTION 28

Please indicate well location X.

ADDITIONAL INFORMATION

If more than one screen, show locations of each on sketch.