

WILKINSON

N 6

7-23-70

MISSISSIPPI BOARD OF WATER COMMISSIONERS
416 North State Street
Jackson, Mississippi 39201

CODED

WATER WELL DRILLERS LOG

July 23, 70 Chester Kernes Wilkinson
date well completed firm name county well located

LANDOWNER: Joe Smith

description of formations encountered from to

Woodville Miss
(mailing address)

Clay 0 18
Red Sand 18 25

WELL LOCATION:
sec. 31 T. 2 N. R. 1 W.
3 miles ESE Woodville
(distance) (direction) (nearest town)

Sand & pea gravel 25 35
white chalk 35 40

WELL PURPOSE: Home
(home, irrigation, municipal, industrial)

fine sand 40 100

WELL COMPLETION DATA:
(1) diameter (inches) 4"
(2) total depth (feet) 110
(3) static water level (feet) 75 below above top of ground.
(4) casing Plastic bottom
(material) (depth)

Coarse sand & pea gravel 100 110

(size) If telescope see back.

(5) screen 6' 104
(length) (depth to top)
4" Plastic
(size) (material)

CODED

(6) pump 1/2 hp 8
(HP) (yield gpm)
Electric
(type power)

(7) electric log no
(yes or no)

(organization running log)

(8) how well bottom plugged wooden plug


DRILLERS REMARKS:
old well back

SEP 21 1970

MISS. BD. OF WATER COMM

If well telescopes please sketch and show depths.

GROUND LEVEL

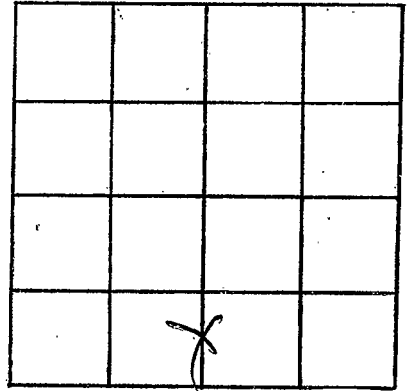

SECTION 31

Please indicate well location X.

ADDITIONAL INFORMATION

If more than one screen,
show locations of each on sketch.