

WILKINSON

N 7
11-15-62

WATER WELL DRILLERS LOG

CODED

Wilkinson

Date: 11-15, 1962, Driller: Henry King Co County: Franklin
(Name)

(1) Owner of Land: Mary Mack Shop
(Name)
Woodalle Miss
(Address)

(2) Location: _____ 1/4, _____ 1/4, Sec. 32 T2R1W
4 miles EAST of Woodalle
(distance) (direction) (Nearest Town)

(3) Topography: _____
(Hilly) (Flat) (Level)

(4) Purpose of Well: Domestic
(Domestic Irrigation
Municipal, Industrial, Other)

Description & Color of Materials Sand, Clay, Red Clay, Shell, etc.	Thick- ness Feet	Depth Feet
<u>Clay</u>	<u>3.00</u>	
<u>Sand</u>		<u>140</u>

Information upon completion of well:

(1) Diameter 4 3/4 inches.

(2) Total Depth 3100 feet.

(3) Water Level 280 feet below top of ground.

(4) Cased to 235, Size 2"

(5) Screen: Size 2", Length 5


(6) Were any formations sealed against pollution?
_____ yes, no.

If YES depth of formation _____

Why _____

Drillers Remarks: _____

CODED

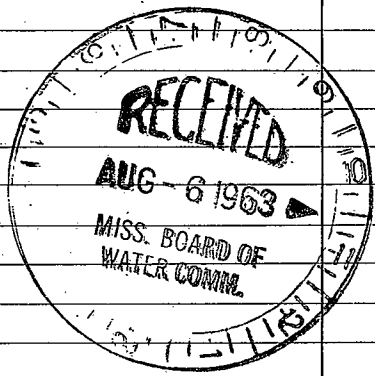

Well No.

(Use Back Side)

