

WILKINSON
 N8
 3-12-71

MISSISSIPPI
 BOARD OF WATER COMMISSIONERS
 416 North State Street
 Jackson, Mississippi 39201

CODED

WATER WELL DRILLERS LOG

3-12
 date well completed

19 71 *Drillers Water Well Ser. Wilkinson*
 firm name

county well located

LANDOWNER:	description of formations encountered	from	to
<i>Leon Welch</i>			
<i>Centreville, Miss.</i> (mailing address)	<i>Sand & Gravel</i>	<i>1</i>	<i>60</i>
	<i>Chalk</i>	<i>60</i>	<i>105</i>
	<i>Sand</i>	<i>105</i>	<i>130</i>
	<i>Chalk</i>	<i>130</i>	<i>160</i>
	<i>Sand</i>	<i>160</i>	<i>196</i>
WELL LOCATION: sec. <i>28</i> T. <i>20</i> N. R. <i>1</i> E. S. <i>5</i> <i>8</i> miles <i>east</i> of <i>Woodville</i> (distance) (direction) (nearest town)			
WELL PURPOSE: <i>Home</i> (home, irrigation, municipal, industrial)			
WELL COMPLETION DATA:			
(1) diameter (inches) <i>2"</i>			
(2) total depth (feet) <i>196'</i>			
(3) static water level (feet) <i>84'</i> below top of ground.			
(4) casing <i>Galv.</i> <i>189'</i> (material) (depth) <i>2"</i> if telescope see back. (size)			
(5) screen <i>5'</i> <i>189'</i> (length) (depth to top) <i>2"</i> <i>SS</i> (size) (material)			
(6) pump _____ (HP) _____ (yield gpm) (type power)			
(7) electric log <i>no</i> (yes or no) (organization running log)			
(8) how well bottom plugged <i>wood plug</i>			
DRILLERS REMARKS:			


CODED

APR 21 1971

MISS. Bd. of
 WATER COMMISSIONERS

If well telescopes please sketch and show depths.

GROUND LEVEL

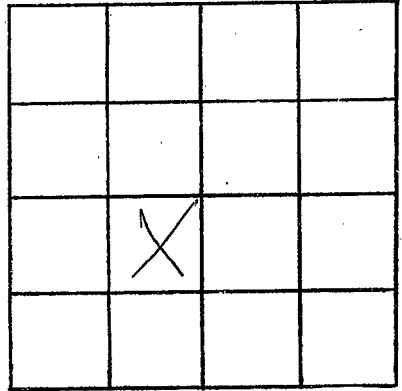

SECTION 28

Please indicate well location X.

ADDITIONAL INFORMATION

If more than one screen,
show locations of each on sketch.