

MISSISSIPPI DEPARTMENT OF NATURAL RESOURCES

Bureau of Land and Water Resources

Southport Mall

P.O. Box 10631

Jackson, Mississippi 39209

WATER WELL DRILLERS LOG

N13  
 Wilkinson  
 3-6-84

CODED.

3-6-84 Griner Drilling Service, INC. Wilkinson

date well completed

firm name

county well located

LANDOWNER:  
 Singley Construction  
 Hwy 13 South  
 Columbia, Ms. 39429  
 (mailing address)

description of formations encountered	from	to
	fill dirt	0
sand, gravel	30	84

WELL LOCATION: 500'S + 2140'E  
 Texaco 321 2ND R L E Nulco  
 No. 1333 miles of Woodville  
 John 3 (distance) (direction) of (nearest town)  
 Feb 3

Chalk	84	147
sand, gravel	147	189

WELL PURPOSE: oilfield supply  
 (home, irrigation, municipal, industrial)

Chalk streaks	189	357
---------------	-----	-----

WELL COMPLETION DATA:

SAND	357	462
------	-----	-----

(1) diameter (inches) 4"

chalk	462	567
-------	-----	-----

(2) total depth (feet) 966'

(3) static water level (feet) 260' below top of ground.

sand, pea gravel	567	651
------------------	-----	-----

(4) casing steel, 966' (material) (depth)

chalk	651	882
-------	-----	-----

4" (size) if telescope see back.

(5) screen 42' 924' (length) (depth to top)

SAND	882	966
------	-----	-----

4" perforated (size) (material)

(6) pump AC (HP) 60 (yield gpm)

(7) electric log (yes or no)

(organization running log)

(8) how well bottom plugged Orange peel

DEPT. OF NATURAL RESOURCES  
 BUREAU OF LAND & WATER RESOURCES

DRILLERS REMARKS:


MAR 27 1984

RECEIVED

If well telescopes please sketch and show depths.

12/22/80

GROUND LEVEL

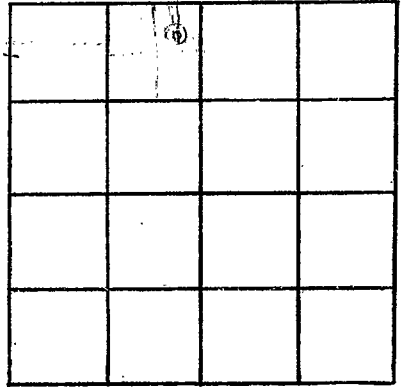

SECTION \_\_\_\_\_

Please indicate well location X.

ADDITIONAL INFORMATION

If more than one screen,  
show locations of each on sketch.