

MISSISSIPPI DEPARTMENT OF NATURAL RESOURCES

Bureau of Land and Water Resources

Southport Mall

P.O. Box 10631

Jackson, Mississippi 39209

WATER WELL DRILLERS LOG

CODED

Wilkinson  
N 14  
10/17/84

10/17/84 Rayborn Drilling Wilkinson  
date well completed firm name county well located

LANDOWNER:  
Shamrock Drilling  
Notcher, ms  
(mailing address)

description of formations encountered	from	to
Top Soil	0	10
sand	11	35
Chalk	30	250
sand	251	370
Chalk	371	371
sand	372	391
Chalk	392	410
sand	411	441

WELL LOCATION:  
sec. 18 T 2 N R 1 E  
S W  
2 miles west of Woodville  
(distance) (direction) (nearest town)

WELL PURPOSE: oil field  
(home, irrigation, municipal, industrial)

- WELL COMPLETION DATA:
- (1) diameter (inches) 3"
  - (2) total depth (feet) 441'
  - (3) static water level (feet) 150' below top of ground.
  - (4) casing blk pipe, 421' (material) (depth)  
3" (size) if telescope see back.
  - (5) screen 20', 421' (length) (depth to top)  
3", slotted pipe (size) (material)
  - (6) pump 50 (HP) (yield gpm)  
— (type power)
  - (7) electric log no (yes or no)  
— (organization running log)
  - (8) how well bottom plugged wood

CODED


lease Name:  
Woodace Mars #1  
627' N + 206' W  
of SE / cor Sec 18  
2N, 1W

RECEIVED  
JAN 24 1985

DRILLERS REMARKS:

If well telescopes please  
sketch and show depths.

GROUND LEVEL

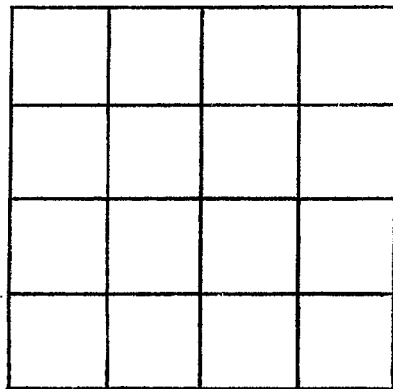

SECTION \_\_\_\_\_

Please indicate well location X.

ADDITIONAL INFORMATION

If more than one screen,  
show locations of each on sketch.