

MISSISSIPPI DEPARTMENT OF NATURAL RESOURCES

Bureau of Land and Water Resources

Southport Mall

P.O. Box 10631

Jackson, Mississippi 39209

WATER WELL DRILLERS LOG

CODED

Griner Drilling Service, Inc.

Wilkinson

N15  
 Wilkinson  
 1-26-85

date well completed

firm name

county well located

LANDOWNER:

Brown & Root  
 P.O. Box 544  
 Collins, MS. 39428  
 (mailing address)

description of formations encountered

from

to

Gravel

0 55

clay, sand

55 105

WELL LOCATION: 1812' N + 1926' E

sec 28 T 2 N R 1 E SW 1/4

sand, pea gravel

105 126

clay, sand

126 245

WELL PURPOSE: oilfield supply  
 (home, irrigation, municipal, industrial)

sand, pea gravel

245 290

clay, sand

290 510

WELL COMPLETION DATA:

(1) diameter (inches) 4"

sand, pea gravel

510 561

(2) total depth (feet) 651'

clay, sand

561 575

(3) static water level (feet) 180' below top of ground.

sand, pea gravel

575 651

(4) casing steel 651' (material) (depth)

4" (size) if telescope see back.

(5) screen 42' 609' (length) (depth to top)

4" perforated (size) (material)

(6) pump 85 (HP) (yield gpm)

AC (type power)

(7) electric log (yes or no)

(organization running log)

(8) how well bottom plugged orange peel


DRILLERS REMARKS:

RECEIVED  
 MAR 13 1985

Department of Natural Resources  
 Bureau of Land & Water Resources

If well telescopes please sketch and show depths.

GROUND LEVEL

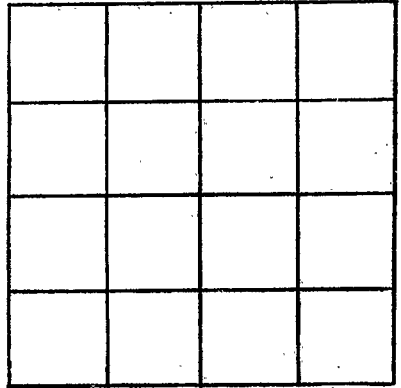

SECTION \_\_\_\_\_

Please indicate well location X.

ADDITIONAL INFORMATION

If more than one screen,  
show locations of each on sketch.