

Wilkinson  
N 16  
6-17-85

MISSISSIPPI  
BOARD OF WATER COMMISSIONERS  
416 North State Street  
Jackson, Mississippi 39201

CODED

WATER WELL DRILLERS LOG

6-17-85 Griner Drilling Service, Inc.

Wilkinson

date well completed

firm name

county well located

LANDOWNER:

W.S. "Red" Hancock, Inc.  
P.O. Box 207  
Bentonla, Ms. 39040  
(mailing address)

description of formations encountered

from

to

Fill dirt	0	50
clay + gravel	50	315
pea gravel	315	420
clay, sand	420	546
sand, gravel	546	609
clay	609	612

WELL LOCATION: 1899 1/2 x 2066 1/2

sec. 28 T 20 N R 1 E cor  
Texaco  
No. 1 Theima Centreville  
Sessions et al (direction) (nearest town)

WELL PURPOSE: oilfield supply  
(home, irrigation, municipal, industrial)

WELL COMPLETION DATA:

- NO. 1 well
- diameter (inches) 4"
  - total depth (feet) 672'
  - static water level (feet) 200' <sup>660</sup> below top of ground.
  - casing steel 609' (material) (depth)  
4" (size) If telescope see back.
  - screen 63' 546' (length) (depth to top)  
4" perforated (size) (material)
  - pump AC (HP) 60 (yield gpm)  
(type power)
  - electric log (yes or no)

(organization running log)


(8) how well bottom plugged orange peel

DRILLERS REMARKS:

RECEIVED  
JUL 11 1985

If well telescopes please sketch and show depths.

GROUND LEVEL

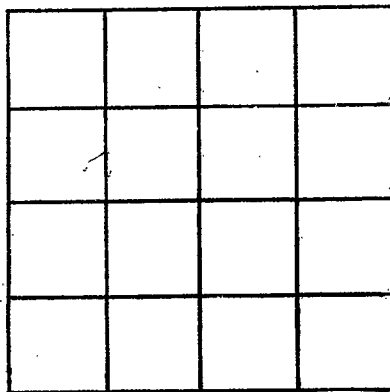

SECTION \_\_\_\_\_

Please indicate well location X.

ADDITIONAL INFORMATION

If more than one screen, show locations of each on sketch.