

Wilkinson

N 17

6-17-85

MISSISSIPPI  
 BOARD OF WATER COMMISSIONERS  
 416 North State Street  
 Jackson, Mississippi 39201

COLED

WATER WELL DRILLERS LOG

Griner Drilling Service, INC

Wilkinson

date well completed

firm name

county well located

LANDOWNER:

W.S. "Red" Hancock, Inc.  
 P.O. Box 207  
 Bentonia, Ms. 39040  
 (mailing address)

description of formations encountered

from to

clay, sand, gravel	0	315
Pea gravel	315	420
clay, sand	420	546
sand, pea gravel	546	609

WELL LOCATION: 1899'S + 2066' W

sec 28 T 20 N R 1 E NE 1/4

Texaco  
 No. 1 Thelma session 6 or 21 miles of Centreville  
 (direction) (nearest town)

WELL PURPOSE: oil field supply (home, irrigation, municipal, industrial)

WELL COMPLETION DATA:

No. 2 well

- (1) diameter (inches) 3"
- (2) total depth (feet) 609'
- (3) static water level (feet) 200' <sup>below</sup> <sub>above</sub> top of ground.
- (4) casing steel, 609'  
(material) (depth)  
3"  
(size) If telescope see back.
- (5) screen 42', 567'  
(length) (depth to top)  
3", perforated  
(size) (material)
- (6) pump —, 60  
(HP) (yield gpm)  
AC  
(type power)
- (7) electric log (yes or no)

(organization running log)

(8) how well bottom plugged orange peel


DRILLERS REMARKS:

RECEIVED

JUL 11 1985

If well telescopes please  
sketch and show depths.

GROUND LEVEL

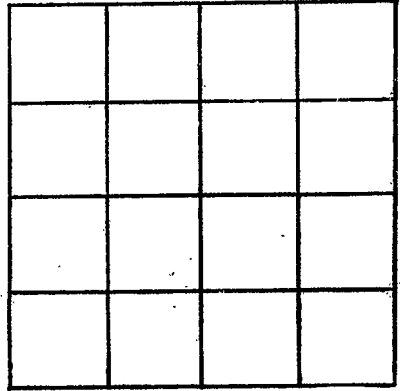

SECTION \_\_\_\_\_

Please indicate well location X.

ADDITIONAL INFORMATION

If more than one screen,  
show locations of each on sketch.