

MISSISSIPPI DEPARTMENT OF NATURAL RESOURCES

Bureau of Land and Water Resources

Southport Mall

P.O. Box 10631

Jackson, Mississippi 39209

WATER WELL DRILLERS LOG

CODED

WILKINSON
N. 18

Griner Drilling Service, Inc.

Wilkinson

12-11-85
date well completed

firm name

county well located

LANDOWNER:	description of formations encountered	from	to
Tesoro Petroleum P.O. Box 2909 Laurel, Ms. 39442 (mailing address)	clay, SAND	0	252
WELL LOCATION: 500'S & 575'W sec. 34 T 2 N R 1 E OF Albert Newtonia ^W NE/CO L. Miller miles field of SE NE (distance) (direction) (nearest town)	clay	252	336
	SAND	336	462
	streaked	462	567
WELL PURPOSE: oilfield supply (home, irrigation, municipal, industrial)	SAND	567	693
WELL COMPLETION DATA:			
(1) diameter (inches) 3"			
(2) total depth (feet) 693'			
(3) static water level (feet) 220' ^{below} _{above} top of ground.			
(4) casing steel, 693' (material) (depth) 3" (size) if telescope see back.			
(5) screen 63', 630' (length) (depth to top) 3" perforated (size) (material)			
(6) pump - 75-80 (HP) (yield gpm) AC (type power)			
(7) electric log (yes or no)			
(organization running log)			
(8) how well bottom plugged orange peel			
DRILLERS REMARKS:			

CODED


RECEIVED

JAN 13 1986

Department of Natural Resources
Bureau of Land & Water Resources

If well telescopes please
sketch and show depths.

GROUND LEVEL

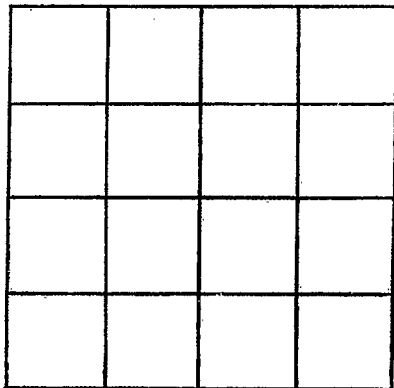

SECTION _____

Please indicate well location X.

ADDITIONAL INFORMATION

If more than one screen,
show locations of each on sketch.