

MISSISSIPPI DEPARTMENT OF NATURAL RESOURCES

Bureau of Land and Water Resources

Southport Mall

P.O. Box 10631

Jackson, Mississippi 39209

WATER WELL DRILLERS LOG

CODED

Wilkinson
N 19

2-12-86 Griner Drilling Service, Inc. Wilkinson
 date well completed firm name county well located

LANDOWNER:	description of formations encountered	from	to
<u>W.S. "Red" Hancock, Inc.</u> <u>oil field construction</u> <u>P.O. Box 207</u> <u>Bentonia, Ms. 39040</u> (mailing address)	<u>STREAKED, MOSTLY</u> <u>CLAY</u>	<u>0</u>	<u>190</u>
WELL LOCATION: <u>615'N + 825'W</u> sec. <u>28</u> T. <u>20</u> R. <u>1</u> E. OF <u>Texaco, Inc.</u> <u>SE/4</u> <u>No. 1</u> mile <u>W</u> of <u>Woodville</u> <u>A.B. Walker</u> (distance) (direction) (nearest town)	<u>SAND, PEA GRAVEL</u>	<u>190</u>	<u>220</u>
WELL PURPOSE: <u>oil field</u> (home, irrigation, municipal, industrial) <u>supply</u>	<u>CLAY, FEW SAND</u> <u>+ SHELL BREAKS</u>	<u>220</u>	<u>350</u>
WELL COMPLETION DATA:	<u>SAND, PEA GRAVEL</u>	<u>350</u>	<u>410</u>
(1) diameter (inches) <u>4"</u>	<u>CLAY</u>	<u>410</u>	<u>510</u>
(2) total depth (feet) <u>924'</u>	<u>SAND, BLACK PEA</u> <u>GRAVEL</u>	<u>510</u>	<u>610</u>
(3) static water level (feet) <u>250'</u> <u>below</u> top of ground.	<u>CLAY, SMALL SAND</u> <u>BREAKS</u>	<u>610</u>	<u>860</u>
(4) casing <u>steel</u> <u>924'</u> (material) (depth) <u>4"</u> (size) if telescope see back.	<u>COURSE SAND</u> <u>little pea gravel</u>	<u>860</u>	<u>924'</u>
(5) screen <u>63'</u> <u>861'</u> (length) (depth to top) <u>4"</u> <u>perforated</u> (size) (material)			
(6) pump <u>—</u> <u>70-75</u> (HP) (yield gpm) <u>AC</u> (type power)			
(7) electric log <u>(yes or no)</u> (organization running log)			
(8) how well bottom plugged <u>ORANGE</u> <u>peel</u>			
DRILLERS REMARKS:			


CODED

RECORDED
FEB 20 1986

Department of Natural Resources
 Bureau of Land & Water Resources

If well telescopes please sketch and show depths.

GROUND LEVEL

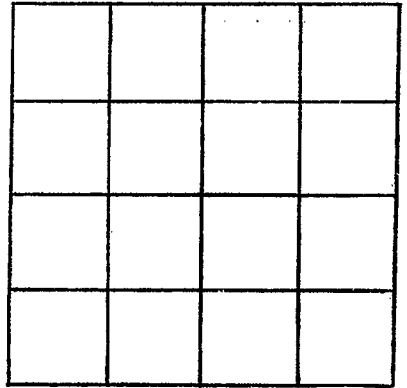

SECTION _____

Please indicate well location X.

ADDITIONAL INFORMATION

If more than one screen,
show locations of each on sketch.