

MISSISSIPPI DEPARTMENT OF NATURAL RESOURCES

Bureau of Land and Water Resources

Southport Mall

P.O. Box 10631

Jackson, Mississippi 39209

WATER WELL DRILLERS LOG

CODED

WILKINSON  
NO 20  
1-26-86

1-26-19 86 Tom Griffith Wheat Wells Co. Wilkerson  
date well completed Bess Enterprises, PO Box 6970 firm name county well located

LANDOWNER: Energy Drilling description of formations encountered from to  
PO Box 905 Metairie, LA 70009-6970  
New Orleans, LA Streaked cherty 1 440  
Natchez, MS 39120 sand sand 440 500  
(mailing address)

WELL LOCATION:  
sec. 18 T 2 (N) R 1 E  
S (W)  
4 miles SW of Woodville  
(distance) (direction) (nearest town)

WELL PURPOSE: oil loc  
(home, irrigation, municipal, industrial)

- WELL COMPLETION DATA:
- (1) diameter (inches) 4"
  - (2) total depth (feet) 500'
  - (3) static water level (feet) 210 below above top of ground.
  - (4) casing PVC 440'  
(material) (depth)  
NA if telescope see back.  
(size)
  - (5) screen 60' 440'  
(length) (depth to top)  
4" PVC factory slot  
(size) (material)
  - (6) pump 5 30-50  
(HP) (yield gpm)  
Elec  
(type power)
  - (7) electric log no  
(yes or no)  
NA  
(organization running log)
  - (8) how well bottom plugged BWV

RECEIVED


MAR 27 1986

Department of Natural Resources  
Bureau of Land & Water Resources

DRILLERS REMARKS:  
Pumping level 250'

If well telescopes please sketch and show depths.

GROUND LEVEL

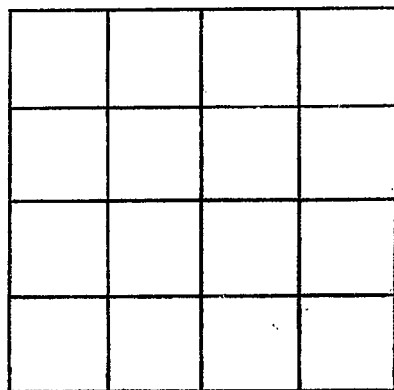

SECTION \_\_\_\_\_

Please indicate well location X.

ADDITIONAL INFORMATION

If more than one screen,  
show locations of each on sketch.