

MISSISSIPPI DEPARTMENT OF NATURAL RESOURCES

Bureau of Land and Water Resources

Southport Mall

P.O. Box 10631

Jackson, Mississippi 39209

WATER WELL DRILLERS LOG

WILKINSON  
N 21  
12-11-87

Coded

Griner Drilling Service, Inc.

Wilkinson

12-11-87  
date well completed

Griner Drilling Service, Inc.  
firm name

Wilkinson  
county well located

LANDOWNER:	description of formations encountered	from	to
See Land Drilling Co. 900 Dunn Street HOUMA, LA. 70360 (mailing address)	fill	0	12
WELL LOCATION: 3200'N + 1650'W sec. 17 T-20 S R-1 E of No. 1 Leake J. J. Leake 17.7 miles Woodville (distance) (direction) of (nearest town)	clay, rocks	12	150
WELL PURPOSE: oilfield rig (home, irrigation, municipal, industrial) supply	streaked sand	150	170
WELL COMPLETION DATA:	clay	170	196
(1) diameter (inches) 4"	fine sand	196	215
(2) total depth (feet) 296'	good sand	215	260
(3) static water level (feet) 90' <sup>below</sup> <sub>above</sub> top of ground.	streaked	260	275
(4) casing steel 252' (material) (depth) 4" (size) if telescope see back.	clay	275	296
(5) screen 20' 296' (length) (depth to top) 4" stainless steel (size) (material)			
(6) pump 5 85 (HP) (yield gpm) 230 volt 3 phase (type power)			
(7) electric log <input checked="" type="checkbox"/> (yes or no) (organization running log)			
(8) how well bottom plugged 4" backwash valve			
DRILLERS REMARKS:			


RECEIVED

JAN 4 1988

Department of Natural Resources  
Bureau of Land & Water Resources

If well telescopes please sketch and show depths.

GROUND LEVEL

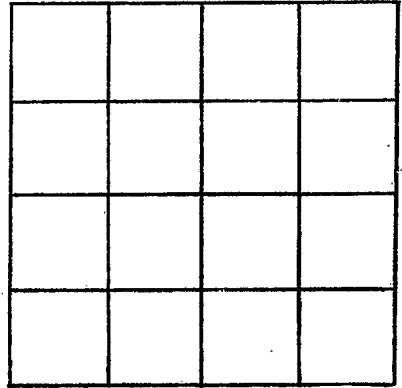

SECTION \_\_\_\_\_

Please indicate well location X.

ADDITIONAL INFORMATION

If more than one screen, show locations of each on sketch.