

MISSISSIPPI DEPARTMENT OF NATURAL RESOURCES

Bureau of Land and Water Resources

Southport Mall

P.O. Box 10631

CODED

Jackson, Mississippi 39209

WATER WELL DRILLERS LOG

WILKERSON
N 23

325

6-09

1991

Morphis Brothers

Wilkerson

date well completed

firm name

county well located

LANDOWNER: Plains Resources

description of formations encountered

from

to

1600 Smith St Cullen Center

Clay Gravel Sand 0 20

Houston, Texas 77002
(mailing address)

White Clay 20 100

White Clay 5' Sandy Clay 100 120

Sand 120 140

Coarse Sand 140 157

WELL LOCATION:

sec. 30 T. 2 (N) R. 1 E
S 5 miles E of Woodville
(distance) (direction) (nearest town)

#1 JOHNSON FEE

WELL PURPOSE: Rig Supply
(home, irrigation, municipal, industrial)

1773' N E 713' W OF

WELL COMPLETION DATA:

SE/col

- (1) diameter (inches) 4
- (2) total depth (feet) 157
- (3) static water level (feet) _____ below above top of ground.

- (4) casing PVC, 137 (material) (depth)
4" (size) if telescope see back.


- (5) screen 20, 137 (length) (depth to top)
.025, PVC (size) (material)

- (6) pump 5, 70 (HP) (yield gpm)
Elec. (type power)

- (7) electric log NO (yes or no)

(organization running log)

- (8) how well bottom plugged BWV

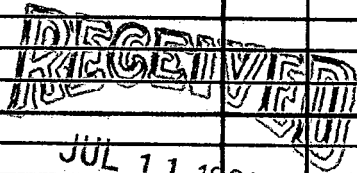


JUL 11 1991

Dept. of Environmental Quality
Bureau of Land & Water Resources

DRILLERS REMARKS:

If well telescopes please
sketch and show depths.

GROUND LEVEL

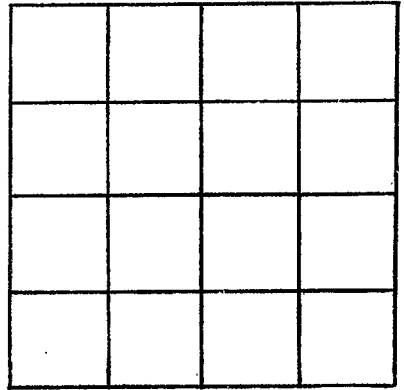

SECTION _____

Please indicate well location X.

ADDITIONAL INFORMATION

If more than one screen,
show locations of each on sketch.