

MISSISSIPPI DEPARTMENT OF ENVIRONMENTAL  
**QUALITY**  
 Office of Land and Water Resources

P. O. Box 10631  
 Jackson, MS 39289-0631  
**WATER WELL DRILLERS LOG**

COUNTY WELL LOCATED  
Wilkinson  
 WELL NUMBER N-095 CODED  
 DATE WELL COMPLETED  
8-13-03

PERMIT NUMBER  
0-60  
 NAME OF DRILLING FIRM  
Kayborn Drilling  
Watches MS

NAME & MAILING ADDRESS OF LANDOWNER  
Mike Green  
14494 Carroll Ave.  
Walker LA 70785  
 Latitude:  
 Longitude:  
 WELL LOCATION. SEC TOWNSHIP RANGE  
16 2 N 1 W  
 DISTANCE DIRECTION NEAREST TOWN  
5 Miles NW of Woodville  
 OTHER LANDMARK  
 WELL PURPOSE (Home) Irrigation, Municipal, Industrial, Fish Pond, etc.

**PUMP DATA**

PUMP TYPE (Circle One):  
~~Submersible?~~ Turbine, Jet, Flowing Well,  
 Other (Describe) \_\_\_\_\_  
 POWER TYPE (Circle One):  
~~Electric?~~ Tractor, Diesel, Gasoline, Butane,  
 Other (Describe) \_\_\_\_\_ H/P 1

DESCRIPTION OF FORMATIONS ENCOUNTERED	FROM	TO
Soft chalk	0	20
hard chalk	20	60
chalk & Sand Stone	60	80
Chalk	80	165
Fine sand	165	180
med sand	180	200
Pea Gravel	200	220

**RECEIVED**  
 AUG 19 2003  
 BY: OLWR

Top of Lap Pipe or Reduction in Casing

FEET  IF TELESCOPED OR MORE THAN ONE SCREEN: USE BACK PAGE

**WELL DATA**

Well Depth <u>220</u>	Casing Diameter (In.) <u>4"</u>	Casing Length (Ft.) <u>200</u>
Type of Casing <u>PVC</u>	Hole Depth <u>220</u>	Depth to Static Water Level <u>95'</u>

TYPE OF COMPLETION: (Circle One or More):  
~~Gravel Packed?~~ Underreamed, Telescoped,  
 Natural Development, Open Hole, Other  
 (Describe) \_\_\_\_\_

WELL GROUTED TO A DEPTH OF 10 FEET  
 Type Grout (circle one): Cement, Bentonite, or Mix

**SCREEN DATA**

Diameter - Inches <u>4</u>	Length - Feet <u>20</u>	Slot Size - Inches <u>.010</u>
Screen Type <u>PVC</u>	Depth to Bottom - Feet <u>220</u>	

I certify that the well was drilled, constructed and completed in accordance with all applicable Requirements of the Mississippi Department of Environmental Quality and/or the Mississippi Department of Health regulations and state laws.


*(Signature)* 0-60  
 Signature of Licensed Driller and License No.

8-15-03  
 Date

Additional Information Required On Back

If well telescopes please sketch and show depths.

GROUND LEVEL

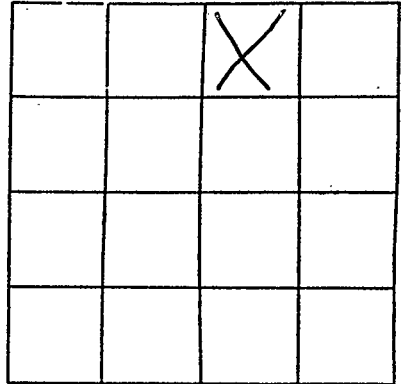

SECTION 16

Please indicate well location X.

Pump Capacity (GPM)	No. of Stages	Setting Depth	
<u>12</u>	<u>14</u>	<u>130</u>	FT.

PUMP TEST

Well yielded \_\_\_\_\_ GPM with  
 a drawdown of \_\_\_\_\_ ft.  
 after \_\_\_\_\_ hours of pumping

LOG DATA

TYPE OF LOG RUN (Circle One): NO Log Run  
 Electric, Gamma Ray, Density, Sonic, Neutron,  
 Other (Describe) \_\_\_\_\_

Name of Organization Running Log \_\_\_\_\_

GEOLOGIC DATA (Office Use Only)

Surface Elev.	Geologic Unit	Unit Thickness	Depth to Top
Subs. SWL	Date	Analysis	Aquifer Test

Driller's Remarks

---



---



If more than one screen,  
 show location of each on sketch.