
	State Well Rep	ort	, For Office Use Only:	
	Part 1		For Office Use Omy:	
ounty: Wilkinson	Mississippi Department of Enviro	onmental Quality	Aquifer:	
ermit #:	Office of Land and Water	Resources	Well #: <u>N-33</u>	
Ca Da haca	P.O. Box 10631		· ·	
riller: Gary Rayborn	Jackson, MS 39289-	0631	L. S. Elevation:	
Date drilling completed: <u>1-17-08</u>	(601)961-5210			
	(601)354-6938 (fa	x)	E-log #:	
State Law requires that this rep	ort be prepared by the driller in			
30 days of completion of drilling of the well. Well Owner Information		We	Vell Location	
wher Name Carol M. Si	nith Latitude:	o ,	_" Longitude:°'	
Tailing Address:		of Lat/Long (circle o	ne): Conventional Survey,	
458 Natchez St		USGS quad, Hand-held GPS, Survey-grade GPS		
Woodville N		14 Sec_31	Twn 2N Rng IW	
City St.	ate Zin Code l	Direction	Nearest Town,	
elephone No. (601) 888 - 49	302 3.5	Miles <u>east</u>	of Wood of He	
	Well Data	<u></u>		
Purpose of Well (circle one) Home In	dustrial Public Supply Irrigatic	n Fish Culture	Other:	
Date well drilling started: $1-17$				
f flowing, method of flow regulation: Va		. <u></u>		
f flowing, method of flow regulation: Va	alve Outer (describe) _		1-17-2008	
Static Water Level: <u>50</u> feet a				
Method of Measurement (circle one)				
Hole depth: <u>120'</u> Well d	epth: <u>120'</u> Well g	routed to a depth of	feet	
Type of grout (circle one): Cement	Bentonite Mix		DUC	
Casing length: 100 feet Cas	ing diameter:inches		-	
Screen length: <u>20</u> feet Scr	reen diameter: <u> </u>		• •	
Screen slot size: 1010 inches	Setting depth: From 100	feet to	120 feet	
Type of completion (circle all applicable): Gravel packed Underreamed	Telescoped Ope	en hole Natural Development	
	Other (describe):			
Top of lap pipe or reduction in casing:	feet If telescoped	or more than one s	creen, describe on back of page	
Logs run (circle all applicable) No log r	Electric Gamma Ray Densit	Sonic Neutron	Other:	
Name of organization running log(s): I certify that the well was drilled, cons	tructed, and completed in accordan	ce with all applicab	le requirements of the Mississipp	
Department of Environmental Quality	and/or the Mississippi Department	of Health regulatio	ns and state laws.	
separation of survivolation Quanty		-		
and the second	0-60	7		
omouth draining, nic.	······································			
Print Name of Water Well Contractor an		Signature	of Water Well Contractor	
		Signature	RECEIVED	
		Signature	FEB 0 4 2008	

' If well telescopes please sketch below and show depths.



Description of Formations Encountered	From	To
Clay	0	15
Red Clay Gravel	13	<u> 40</u>
Red sand + Clay	40	80
Sand	80	120

If more than one screen, show location of each on sketch

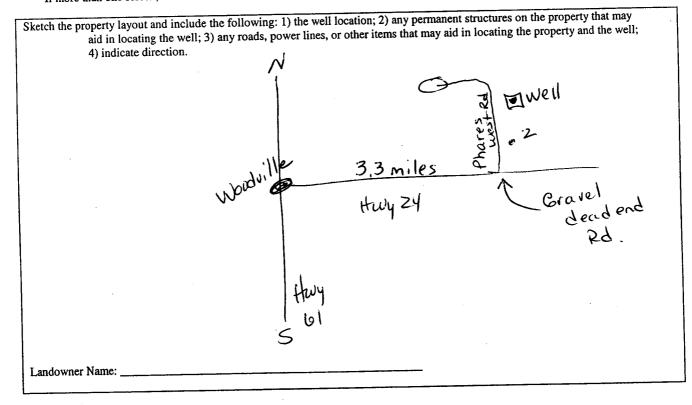

Signature of Water Well Contractor

FEB 0 4 2008 BY: OLWR

۲				
,		LL REPORT		
County: <u>Wilkinson</u> Permit #: Driller: Gary Rayborn Date completed: <u>1-17-08</u>	Part 2 Pump Installer's Completion Report Mississippi Department of Environmental Quality Office of Land and Water Resources P.O. Box 10631 Jackson, MS 39289-0631 (601)961-5210 (601)354-6938 (fax)		For Office Use Only: Aquifer: Well #: Elevation:	
This report should be prepared by the			L nent within 30 days of the	
installation of pump. Well Owner Informati			Vell Location	
wher Name: Carrol M. Smith		Latitude:Longitude:		
		Method of Lat/Long (circle one): Conventional Survey,		
Tailing Address:	22 stongt	USGS quad, Hand-held GPS, Survey-grade GPS		
	^	$\frac{14}{14} = \frac{14}{14} \operatorname{Sec} \frac{31}{14} \operatorname{Twn} \frac{2N}{2N} \operatorname{Rng} \frac{100}{14} = \frac{14}{14} \operatorname{Sec} \frac{31}{14} \operatorname{Twn} \frac{2N}{14} \operatorname{Rng} \frac{100}{14} = \frac{14}{14} \operatorname{Sec} \frac{31}{14} \operatorname{Twn} \frac{31}{14} \operatorname{Sec} \frac{31}{14} \operatorname{Twn} \frac{31}{14} \operatorname{Rng} \frac{100}{14} = \frac{14}{14} \operatorname{Sec} \frac{31}{14} \operatorname{Twn} \frac{31}{14} \operatorname{Sec} \frac{31}{14} \operatorname{Sec} \frac{31}{14} \operatorname{Twn} \frac{31}{14} \operatorname{Sec} 3$		
Woodville US 39669 City State Zip Code				
Telephone No. <u>(001)</u> 888 - 48()2	Distance Direction Nearest Town <u>3.5 Miles Cast of Wood Jille</u>		
Ритр Туре			Power Type	
Circle one			Circle one	
Air Lift Jet 🤇	Submersible	Diesel Engine Gaso	oline Engine Natural Gas	
Bucket Piston	Turbine	Electric Motor Har	nd Tractor PTO	
Centrifugal Rotary	Flowing Well		er (specify):	
Other (specify):		Horse Power Rating of Mo	tor: HP	
Date Pump Installed: 17-C	08	Setting Depth:feet		
Rated Pump Capacity:O	_Gallons Per Minute	Number of Stages:	2	
Pump Test Data		Method of	Measuring Water Level	
Date Well Tested: [-17-08			Circle one	
A	t Below Land Surface	Air Line Electric M	Measuring Line) Steel Tape	
Pumping Water Level (B):Feet	Below Land Surface	Other (specify):		
Drawdown [(B) – (A)]:Feet		For flowing well, measure	d shut in head:feet	
Test Pumping Rate:	Gallons Per Minute		GPM with a drawdown of	
Duration of Pump Test (minimum 4 hours)			erhours of pumping	
I HEREBY CERTIFY that the above states <u>6ary Rayborn</u> Print Name of Pump Installer and License	2-60	of my knowledge.		
			FEB 0 4 2008	
			BY: OLWR	