

Wilkinson

N 2000

6/20/77

MISSISSIPPI
 BOARD OF WATER COMMISSIONERS
 416 North State Street
 Jackson, Mississippi 39201

WATER WELL DRILLERS LOG

June 20 1977
date well completed

145 Covington
firm name

Wilkinson
county well located


LANDOWNER: <u>J.R. Williams</u>	description of formations encountered	from	to
<u>Woodville Miss</u>	CLAY	0	35
(mailing address)	SANDY CLAY	35	70
WELL LOCATION:	CHALK	70	95
sec. <u>28</u> T. <u>2</u> N. R. <u>1</u> E.	SAND	95	114
4 miles E. of Woodville			
(distance) (direction) (nearest town)			
WELL PURPOSE: <u>HOME</u>			
(home, irrigation, municipal, industrial)			
WELL COMPLETION DATA:			
(1) diameter (inches) <u>4</u>			
(2) total depth (feet) <u>114</u>			
(3) static water level (feet) <u>95</u> below top of ground.			
(4) casing <u>PLASTIC, 107</u>			
(material) (depth)			
<u>4</u> if telescope see back.			
(size)			
(5) screen <u>7</u> <u>107</u>			
(length) (depth to top)			
<u>4</u> <u>PLASTIC</u>			
(size) (material)			
(6) pump <u>1/2</u> <u>5</u>			
(HP) (yield gpm)			
(type power)			
(7) electric log _____			
(yes or no)			
(organization running log)			
(8) how well bottom plugged <u>WOOD</u>			
DRILLERS REMARKS:			

RECEIVED

AUG 10 1977

If well telescopes please sketch and show depths.

GROUND LEVEL

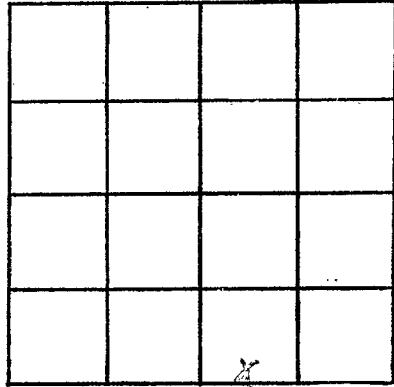

SECTION 28

Please indicate well location X.

ADDITIONAL INFORMATION

If more than one screen, show locations of each on sketch.