

WILKINSON

N 2001

7-25-77

MISSISSIPPI BOARD OF WATER COMMISSIONERS
416 North State Street
Jackson, Mississippi 39201

WATER WELL DRILLERS LOG

7-25
date well completed

14E 27 Rayborn Drill & Const. Co. Wilkinson
firm name

county well located

LANDOWNER:	description of formations encountered	from	to
Lamar Swain			
Woodville Miss. (mailing address)	red clay	2	5
WELL LOCATION:	grey clay	5	43
sec. 18 T 20 N R 1 E S 5	fine sand	43	53
3 miles NE of Woodville (distance) (direction) (nearest town)	grey clay	53	112
WELL PURPOSE: Home (home, irrigation, municipal, industrial)	sand	112	135

- WELL COMPLETION DATA:
- (1) diameter (inches) 2"
 - (2) total depth (feet) 135'
 - (3) static water level (feet) 83' below top of ground.
 - (4) casing galv. 126'
(material) (depth)
 - 2" (size) if telescope see back.
 - (5) screen 5' 126'
(length) (depth to top)
 - 2" 55"
(size) (material)
 - (6) pump 1 5 gpm
(HP) (yield gpm)
 - elec.
(type power)
 - (7) electric log no
(yes or no)

(organization running log)
(8) how well bottom plugged wood plug

DRILLERS REMARKS:


RECEIVED

SEP 20 1977

MISS. BD. OF WATER

If well telescopes please sketch and show depths.

GROUND LEVEL

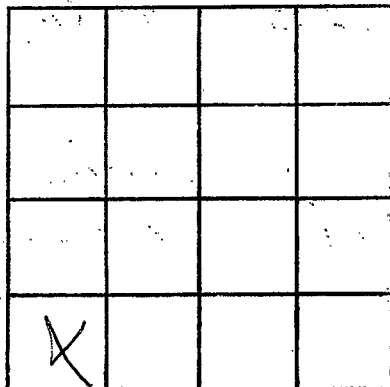

SECTION 18

Please indicate well location X.

ADDITIONAL INFORMATION

If more than one screen,
show locations of each on sketch.