

WELKINSON
N 2003

MISSISSIPPI
BOARD OF WATER COMMISSIONERS
416 North State Street
Jackson, Mississippi 39201

4-29-80
April 29, 1980

WATER WELL DRILLERS LOG

date well completed

firm name

county well located

Reem Miller Wilkerson

LANDOWNER:
Jim Show's
Mt. Crosby
(mailing address)

description of formations encountered	from	to
clay	0	17
sand & gravel	17	50
blue shale	50	195
fine blue sand	195	245
sand	245	273

WELL LOCATION:
sec. 1 T 2 N R 1 E
8 miles N-NW of Centerville
(distance) (direction) (nearest town)

WELL PURPOSE: home
(home, irrigation, municipal, industrial)

- WELL COMPLETION DATA:
- (1) diameter (inches) 4"
 - (2) total depth (feet) 273
 - (3) static water level (feet) 153 below top of ground
 - (4) casing plastic bottom (material) (depth)
 - (5) screen 10" (length) 263' (depth to top)
 - (6) pump 1 1/2 HP (HP) 15 (yield gpm)
 - (7) electric log (type power) (yes or no)

(organization running log)

(8) how well bottom plugged
back west valve

DRILLERS REMARKS:


DEPT. OF NATURAL RESOURCES
BUREAU OF LAND & WATER RESOURCES

JAN 12 1981

RECEIVED

If well telescopes please sketch and show depths.

GROUND LEVEL

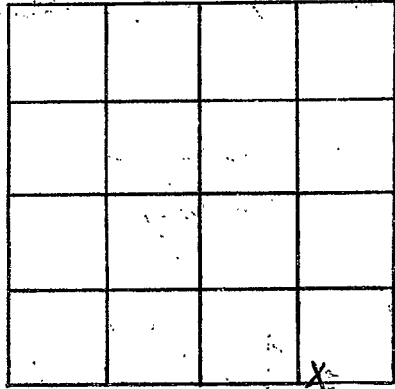

SECTION 1

Please indicate well location X.

ADDITIONAL INFORMATION

If more than one screen, show locations of each on sketch.