

WILKINSON  
N 2004

MISSISSIPPI  
BOARD OF WATER COMMISSIONERS  
416 North State Street  
Jackson, Mississippi 39201

WATER WELL DRILLERS LOG

7/17/80

July 19 1980 Reems Well Ser Wilkinson  
date well completed firm name county well located

LANDOWNER:

Bill Rowell

M. Gloster

(mailing address)

description of formations encountered

from to

clay

0 15

sand

15 25

clay

25 42

sand

42 70

fine Chalk + fine sand

70 250

coarse sand

250 263

WELL LOCATION:


sec. 12 T 2 N R 1 E  
17 miles WNW of Central (distance) (direction) (nearest town)

WELL PURPOSE:

(home, irrigation, municipal, industrial)

WELL COMPLETION DATA:

- (1) diameter (inches) 4"
- (2) total depth (feet) 263
- (3) static water level (feet) 120 below top of ground.
- (4) casing 4" bottom (material) (depth)
- if telescope see back. (size)
- (5) screen 10' 253' (length) (depth to top)
- plastic (size) (material)
- (6) pump 1-1/2 HP 15 (yield.gpm)
- elect (type power)
- (7) electric log no (yes or no)
- (organization running log)

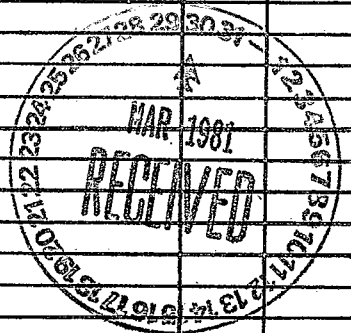


(8) how well bottom plugged  
wooden plug

DRILLERS REMARKS:

If well telescopes please sketch and show depths.

GROUND LEVEL

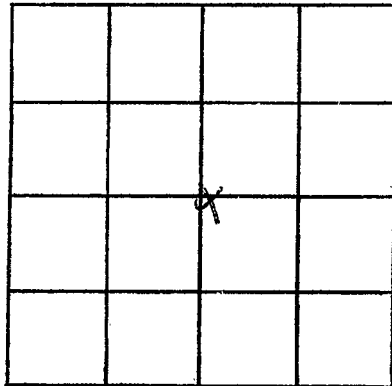

SECTION 12

Please indicate well location X.

ADDITIONAL INFORMATION

If more than one screen, show locations of each on sketch.