

WILKINSON
 N 2005
 8-1-81

MISSISSIPPI
 BOARD OF WATER COMMISSIONERS
 416 North State Street
 Jackson, Mississippi 39201

WATER WELL DRILLERS LOG

8-1-1981 date well completed
 St. United Pump & Well Sup. Co. firm name
 WILKINSON county well located

LANDOWNER: T. J. Rock
 Rt 1 B 139
 Centerville, Mo. 39631
 (mailing address)

description of formations encountered	depth	
	from	to
Clay	0	15
sand & gravel	15	50
Clay	50	79
sand	79	95
Clay	95	150
incomb	150	170

WELL LOCATION:
 sec 21 T 20 N R 1 S
 10 miles N.W. of Centerville
 (distance) (direction) (nearest town)

WELL PURPOSE: Home
 (home, irrigation, municipal, industrial)

WELL COMPLETION DATA:
 (1) diameter (inches) 4"
 (2) total depth (feet) 160"
 (3) static water level (feet) 90 below top of ground.
 (4) casing PVC 150' (material) (depth)
 (size) if telescope see back.
 (5) screen 10' 10' (length) (depth to top)
 4" PVC (size) (material)
 (6) pump 1/2 10 (HP) (yield gpm)
 220 (type power)
 (7) electric log No (yes or no)
 (organization running log)
 (8) how well bottom plugged b.w. Valul


DRILLERS REMARKS:

DEPT. OF NATURAL RESOURCES
 BUREAU OF LAND & WATER RESOURCES

OCT - 9 1981
 RECEIVED

If well telescopes please sketch and show depths.

GROUND LEVEL

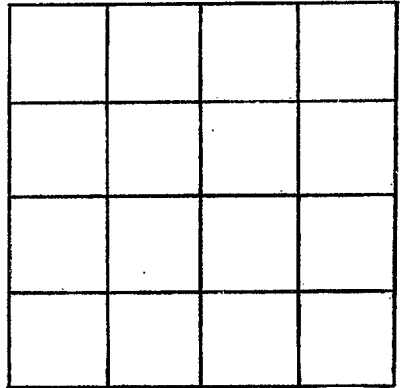

SECTION _____

Please indicate well location X.

ADDITIONAL INFORMATION

If more than one screen, show locations of each on sketch.