

**MISSISSIPPI DEPARTMENT OF NATURAL RESOURCES**  
**Bureau of Land and Water Resources**  
 Southport Mall  
 P.O. Box 10631  
 Jackson, Mississippi 39209  
**WATER WELL DRILLERS LOG**

*Wilkinson*  
*N*  
*2000*

*5-5* 19 *82* *Rayborn Drilling & Concrete - Wilkinson*  
 date well completed firm name county well located

LANDOWNER:	description of formations encountered	from	to
<i>Charles Langlois</i> <i>Woodville, MS</i> (mailing address)			
WELL LOCATION: sec. <i>10</i> T. <i>2</i> S. R. <i>1</i> E. W. <i>W</i> <i>8</i> miles <i>NE</i> of <i>Woodville</i> (distance) (direction) (nearest town)	<i>Chaultc</i>	<i>2</i>	<i>130</i>
	<i>sand</i>	<i>130</i>	<i>250</i>
	<i>chaultc</i>	<i>250</i>	<i>320</i>
	<i>sand</i>	<i>320</i>	<i>375</i>
WELL PURPOSE: (home, irrigation, municipal, industrial)			
WELL COMPLETION DATA:			
(1) diameter (inches) <i>2"</i>			
(2) total depth (feet) <i>375'</i>			
(3) static water level (feet) <i>140'</i> below top of ground.			
(4) casing <i>Galv.</i> (material), <i>365'</i> (depth)			
<i>2"</i> (size) if telescope see back.			
(5) screen <i>10'</i> (length), <i>365'</i> (depth to top)			
<i>2"</i> (size), <i>US-11</i> (material)			
(6) pump <i>-</i> (HP), <i>-</i> (yield gpm)			
<i>-</i> (type power)			
(7) electric log <i>no</i> (yes or no)			
<i>-</i> (organization running log)			
(8) how well bottom plugged <i>wood plug</i>			
DRILLERS REMARKS:			


DEPT. OF NATURAL RESOURCES  
 BUREAU OF LAND & WATER RESOURCES

MAY 21 1982

**RECEIVED**

If well telescopes please sketch and show depths.

GROUND LEVEL

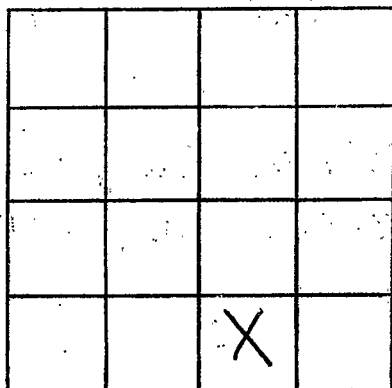

SECTION 10

Please indicate well location X.

ADDITIONAL INFORMATION

If more than one screen,  
show locations of each on sketch.