

MISSISSIPPI DEPARTMENT OF NATURAL RESOURCES  
 Bureau of Land and Water Resources  
 Southport Mall  
 P.O. Box 10631  
 Jackson, Mississippi 39209  
**WATER WELL DRILLERS LOG**

Wilkinson  
N  
2007

Oct 6 1982 News Well Dr Wilkinson Wilkinson  
 date well completed firm name county well located

LANDOWNER: B. D. Cansee  
Woodville  
 (mailing address)

WELL LOCATION:  
 sec 29 T 2 N R 1  
4 miles E of Woodville  
 (distance) (direction) (nearest town)

WELL PURPOSE: Camp  
 (home, irrigation, municipal, industrial)

WELL COMPLETION DATA:  
 (1) diameter (inches) 4"  
 (2) total depth (feet) 108  
 (3) static water level (feet) 88' below top of ground.  
 (4) casing plastic, bottom  
 (material) (depth)  
 (size) if telescope see back.  
 (5) screen 5' 103'  
 (length) (depth to top)  
4" plastic  
 (size) (material)  
 (6) pump by others  
 (HP) (yield gpm)  
split  
 (type power)  
 (7) electric log no  
 (yes or no)  
 (organization running log)

description of formations encountered	from	to
<u>Red Clay</u>	<u>0</u>	<u>25</u>
<u>sands &amp; gravel</u>	<u>25</u>	<u>40</u>
<u>Chalky sand</u>	<u>40</u>	<u>80</u>
<u>coarse sand</u>	<u>80</u>	<u>108</u>

(8) how well bottom plugged back wash

DRILLERS REMARKS:


DEPT. OF NATURAL RESOURCES  
 BUREAU OF LAND & WATER RESOURCES

FEB 24 1983

RECEIVED

If well telescopes please  
sketch and show depths.

GROUND LEVEL

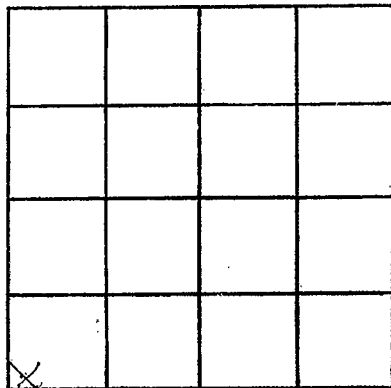

SECTION 29

Please indicate well location X.

ADDITIONAL INFORMATION

If more than one screen,  
show locations of each on sketch.