

Wilkinson
N
2009

MISSISSIPPI DEPARTMENT OF NATURAL RESOURCES
 Bureau of Land and Water Resources
 Southport Mall
 P.O. Box 10631
 Jackson, Mississippi 39209
WATER WELL DRILLERS LOG

10/19/1983 Raydon Drilling & Rest. Wilkinson
 date well completed firm name county well located

LANDOWNER:	description of formations encountered	from	to
<u>Fred Hammond</u> <u>Baton Rouge, LA</u> (mailing address)			
WELL LOCATION: sec. <u>7</u> T <u>20N</u> R <u>1E</u> S W	<u>Sand</u>	<u>11</u>	<u>35</u>
<u>10</u> miles <u>NE</u> of <u>Woodville</u> (distance) (direction) (nearest town)	<u>Lumbe</u>	<u>36</u>	<u>140</u>
WELL PURPOSE: <u>Private</u> (home, irrigation, municipal, industrial)	<u>Sand</u>	<u>141</u>	<u>151</u>
WELL COMPLETION DATA:	<u>Shale</u>	<u>151</u>	<u>220</u>
(1) diameter (inches) <u>4"</u>	<u>Sand</u>	<u>221</u>	<u>255</u>
(2) total depth (feet) <u>255</u>			
(3) static water level (feet) <u>100'</u> <u>below</u> above top of ground.			
(4) casing <u>PVC</u> , <u>245'</u> (material) (depth)			
<u>4"</u> (size) if telescope see back.			
(5) screen <u>10'</u> , <u>245</u> (length) (depth to top)			
<u>4"</u> , <u>PVC</u> (size) (material)			
(6) pump <u>3/4</u> , <u>14</u> (HP) (yield gpm)			
<u>electric</u> (type power)			
(7) electric log <u>NO</u> (yes or no)			
(organization running log)			
(8) how well bottom plugged <u>Wood plug</u>			

DEPT. OF NATURAL RESOURCES
 BUREAU OF LAND & WATER RESOURCES


DEC-7 1983

RECEIVED

DRILLERS REMARKS:

If well telescopes please sketch and show depths.

GROUND LEVEL

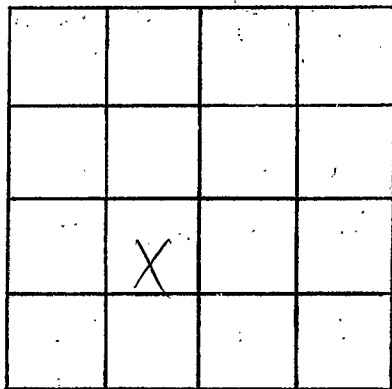

SECTION 7

Please indicate well location X.

ADDITIONAL INFORMATION

If more than one screen,
show locations of each on sketch.