

MISSISSIPPI DEPARTMENT OF NATURAL RESOURCES

Bureau of Land and Water Resources

Southport Mall

P.O. Box 10631

Jackson, Mississippi 39209

WATER WELL DRILLERS LOG

CODED

Wilkinson
Ni 2002

6/9 1986 date well completed Rayborn Drlg Co. firm name Wilkinson county well located

LANDOWNER: <u>Sealand Drlg Co.</u>	description of formations encountered	from	to
<u>900 Dunn St.</u>			
<u>Houma LA 70360</u> (mailing address)	<u>Sand</u>	<u>0</u>	<u>60</u>
WELL LOCATION:	<u>Chalk</u>	<u>60</u>	<u>115</u>
sec. <u>27</u> T. <u>2</u> N. <u>3</u> S. R. <u>1</u> E. <u>W</u>	<u>sand</u>	<u>115</u>	<u>140</u>
<u>7</u> miles <u>east</u> of <u>Woodville</u> (distance) (direction) (nearest town)			
WELL PURPOSE: <u>oilfield</u> (home, irrigation, municipal, industrial)			
WELL COMPLETION DATA:			
(1) diameter (inches) <u>4"</u>			
(2) total depth (feet) <u>140'</u>			
(3) static water level (feet) <u>55'</u> <u>below</u> above top of ground.			
(4) casing <u>40 PVC</u> , <u>120'</u> (material) (depth)			
<u>4"</u> (size) if telescope see back.			
(5) screen <u>20'</u> , <u>120'</u> (length) (depth to top)			
<u>4"</u> , <u>40 slotted PVC</u> (size) (material)			
(6) pump <u>5</u> <u>80</u> (HP) (yield gpm)			
<u>electric</u> (type power)			
(7) electric log <u>no</u> (yes or no)			
(organization running log)			
(8) how well bottom plugged <u>wood</u>			
DRILLERS REMARKS:			

CODED


RECEIVED
JUN 11 1986

SEP 19 1986

Department of Natural Resources
Bureau of Land & Water Resources

If well telescopes please sketch and show depths.

GROUND LEVEL

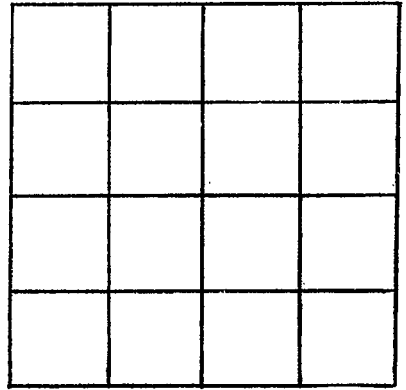

SECTION _____

Please indicate well location X.

ADDITIONAL INFORMATION

If more than one screen,
show locations of each on sketch.