

MISSISSIPPI DEPARTMENT OF NATURAL RESOURCES
 Bureau of Land and Water Resources
 Southport Mall
 P.O. Box 10631
 Jackson, Mississippi 39209
WATER WELL DRILLERS LOG

CODED

WILKINSON
N 2013

7/18 1986 date well completed Rayborn Drlg Co. firm name Wilkinson county well located

| LANDOWNER: <u>Sealand Drlg Co.</u> | description of formations encountered | from | to |
|---|---------------------------------------|-----------|------------|
| <u>900 Dunn St.</u> | | | |
| <u>Houma LA 70360</u> (mailing address) | <u>Shale/Chalk</u> | <u>0</u> | <u>70</u> |
| | <u>Sand</u> | <u>70</u> | <u>100</u> |
| WELL LOCATION: | | | |
| sec. <u>27</u> T. <u>2</u> N. R. <u>1</u> E. <u>W</u> | | | |
| <u>7</u> miles <u>east</u> of <u>Woodville</u> (distance) (direction) (nearest town) | | | |
| WELL PURPOSE: <u>oilfield</u> (home, irrigation, municipal, industrial) | | | |
| WELL COMPLETION DATA: | | | |
| (1) diameter (inches) <u>4"</u> | | | |
| (2) total depth (feet) <u>100'</u> | | | |
| (3) static water level (feet) <u>30'</u> (below/above top of ground) | | | |
| (4) casing <u>Sch 40 PVC</u> , <u>80'</u> (material) (depth) | | | |
| <u>4"</u> (size) if telescope see back. | | | |
| (5) screen <u>20'</u> , <u>80'</u> (length) (depth to top) | | | |
| <u>4"</u> , <u>Sch 40 Slotted PVC</u> (size) (material) | | | |
| (6) pump <u>5</u> <u>60</u> (HP) (yield gpm) | | | |
| <u>electric</u> (type power) | | | |
| (7) electric log <u>no</u> (yes or no) | | | |
| <u></u> (organization running log) | | | |
| (8) how well bottom plugged <u>wood</u> | | | |
| DRILLERS REMARKS: | | | |


CODED

RECEIVED
 SEP 19 1986

Department of Natural Resources
 Bureau of Land & Water Resources

If well telescopes please sketch and show depths.

GROUND LEVEL

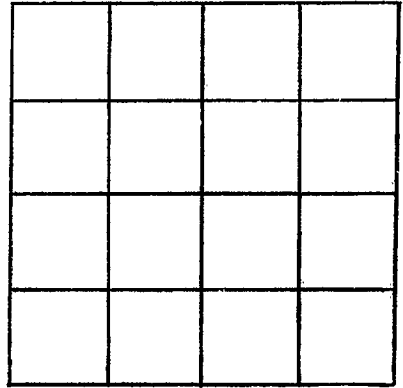

SECTION _____

Please indicate well location X.

ADDITIONAL INFORMATION

If more than one screen, show locations of each on sketch.