

MISSISSIPPI DEPARTMENT OF NATURAL RESOURCES

Bureau of Land and Water Resources

P.O. Box 10631
Jackson, Mississippi 39209
WATER WELL DRILLERS LOG

COUNTY WELL LOCATED <i>Wilkinson</i>	
WELL NUMBER <i>N</i>	CODED
DATE WELL COMPLETED <i>2005 9/27-90</i>	

PERMIT NUMBER
NAME OF DRILLING FIRM <i>FITZGERALD Well Serv</i>

NAME & MAILING ADDRESS OF LANDOWNER <i>Eddie Ryan</i> <i>R.R. Centerville ms.</i>			
WELL LOCATION: SEC	TOWNSHIP	RANGE	
<i>36</i>	<i>2</i>	<i>N</i>	<i>1</i> E
DISTANCE	DIRECTION	NEAREST TOWN	
<i>6</i> Miles	<i>W</i>	<i>Centerville</i>	
OTHER LANDMARK			
WELL PURPOSE: Home, Irrigation, Municipal, Industrial, Fish Pond, etc. <i>Home</i>			

PUMP DATA		
PUMP TYPE (Circle One): <u>Submersible</u> Turbine, Jet, Flowing Well, Other (Describe) _____		
POWER TYPE (Circle One): <u>Electric</u> Tractor, Diesel, Gasoline, Butane, Other (Describe) _____ H/P <i>3/4</i>		
Pump Capacity (GPM) <i>10</i>	No. of Stages <i>12</i>	Setting Depth <i>140</i> FT.
PUMP TEST		
Well yielded <i>25</i> GPM with a drawdown of <i>1</i> ft. after <i>2</i> hours of pumping		

WELL DATA		
Well Depth <i>150</i>	Casing Diameter (In.) <i>4</i>	Casing Length (Ft.) <i>140</i>
Type of Casing <i>PVC</i>	Hole Depth <i>150</i>	Depth to Static Water Level <i>106</i>
TYPE OF COMPLETION: (Circle One or More): <u>Gravel Packed</u> , Underreamed, Telescoped, Natural Development, Open Hole, Other (Describe) _____		
Top of Lap Pipe or Reduction in Casing		
FEET	IF TELESCOPED OR MORE THAN ONE SCREEN: USE BACK PAGE	

LOG DATA	
TYPE OF LOG RUN (Circle One): Electric, Gamma Ray, Density, Sonic, Neutron, Other (Describe) _____ No Log Run	
Name of Organization Running Log	

SCREEN DATA		
Diameter - Inches <i>4</i>	Length - Feet <i>10</i>	Slot Size - Inches <i>10/14</i>
Screen Type <i>PVC</i>	Depth to Bottom - Feet <i>150</i>	


GEOLOGIC DATA (Office Use Only)			
Surface Elev.	Geologic Unit	Unit Thickness	Depth to Top
Subs. SWL	Date	Analysis	Aquifer Test

Driller's Remarks

DESCRIPTION OF FORMATIONS ENCOUNTERED	FROM	TO	FORMATIONS (Continued)	FROM	TO
			<div style="border: 2px solid black; padding: 5px; font-weight: bold; font-size: 1.5em;">RECEIVED</div> <div style="font-weight: bold; font-size: 1.2em; margin-top: 10px;">APR 06 1990</div> <div style="font-weight: bold; font-size: 0.8em; margin-top: 10px;">Department of Natural Resources Bureau of Land & Water Resources</div>		
IF MORE SPACE IS NEEDED, USE BACK					

If well telescopes please
sketch and show depths.


GROUND LEVEL

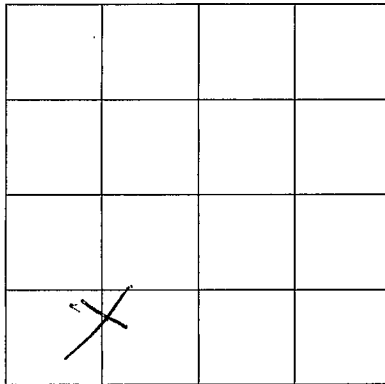

SECTION 36

Please indicate well location X.

ADDITIONAL INFORMATION

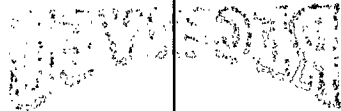

4019... ..
...

If more than one screen,
show location of each on sketch.