

MISSISSIPPI DEPARTMENT OF NATURAL RESOURCES
Bureau of Land and Water Resources
 Southport Mall
 P.O. Box 10631
 Jackson, Mississippi 39209
WATER WELL DRILLERS LOG

Wilkinson
N 207

Nov 19 1992 F. Goodwell Sewer Wilkinson
 date well completed firm name county well located

LANDOWNER:
Clifford Lewis
R.B. Woodruff, Jr.
 (mailing address)

description of formations encountered	from	to
<u>Red Clay</u>	<u>0</u>	<u>20</u>
<u>Red Sand</u>	<u>20</u>	<u>105</u>
<u>white clay</u>	<u>105</u>	<u>116</u>
<u>Coarse sand & gravel</u>	<u>116</u>	<u>128</u>

WELL LOCATION:
 sec. 28 T. 2 N. R. 1 E. S. 3
4 miles NE of Woodville
 (distance) (direction) (nearest town)

WELL PURPOSE: Flora
 (home, irrigation, municipal, industrial)

- WELL COMPLETION DATA:**
- diameter (inches) 4
 - total depth (feet) 128
 - static water level (feet) 72 below above top of ground.
 - casing PVC, 118,
 (material) (depth)
4 if telescope see back.
 (size)
 - screen 10, 118
 (length) (depth to top)
4, PVC
 (size) (material)
 - pump 1/2 10
 (HP) (yield gpm)
Electric
 (type power)
 - electric log no
 (yes or no)
 (organization running log)
 - how well bottom plugged Small


RECEIVED
NOV 27 1991

Department of Natural Resources
 Bureau of Land & Water Resources

DRILLERS REMARKS:

If well telescopes please sketch and show depths.

GROUND LEVEL

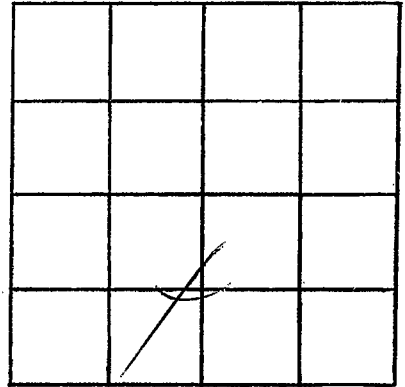

SECTION 28

Please indicate well location X.

ADDITIONAL INFORMATION

If more than one screen,
show locations of each on sketch.