

**MISSISSIPPI DEPARTMENT OF ENVIRONMENTAL
QUALITY**

Office of Land and Water Resources

P. O. Box 10631
Jackson, MS 39289-0631
WATER WELL DRILLERS LOG

COUNTY WELL LOCATED
WILKINSON

WELL NUMBER N CODED

2021
DATE WELL COMPLETED
7-15-93

PERMIT NUMBER

NAME OF DRILLING FIRM
FITZGERALD Well Serv

NAME & MAILING ADDRESS OF LANDOWNER
Mike Smith
B.B. Centerville ms.

WELL LOCATION: SEC 35 TOWNSHIP 2 S RANGE 1 E

DISTANCE 7 Miles DIRECTION W NEAREST TOWN Centerville

OTHER LANDMARK

WELL PURPOSE: Home, Irrigation, Municipal, Industrial, Fish Pond, etc.
Home

PUMP DATA

PUMP TYPE (Circle One):
 Submersible, Turbine, Jet, Flowing Well,
Other (Describe)

POWER TYPE (Circle One):
Electric, Tractor, Diesel, Gasoline, Butane,
Other (Describe) H/P 94

Pump Capacity (GPM) 10 No. of Stages 12 Setting Depth 180 FT.

PUMP TEST

Well yielded 20 GPM with
a drawdown of 2 ft.
after 2 hours of pumping

WELL DATA

Well Depth <u>235</u>	Casing Diameter (In.) <u>4</u>	Casing Length (Ft.) <u>225</u>
Type of Casing <u>N/C</u>	Hole Depth <u>235</u>	Depth to Static Water Level <u>150</u>

TYPE OF COMPLETION: (Circle One or More):
 Gravel Packed, Underreamed, Telescoped,
 Natural Development, Open Hole, Other
(Describe)

LOG DATA

TYPE OF LOG RUN (Circle One):
Electric, Gamma Ray, Density, Sonic, Neutron,
Other (Describe) No Log Run

Name of Organization Running Log

WELL GROUTED TO A DEPTH OF 10 FEET
Type Grout (circle one): Cement, Bentonite or Mix

GEOLOGIC DATA (Office Use Only)

Surface Elev.	Geologic Unit	Unit Thickness	Depth to Top
Subs. SWL	Date	Analysis	Aquifer Test

Driller's Remarks

SCREEN DATA

Diameter - Inches <u>4</u>	Length - Feet <u>10</u>	Slot Size - Inches <u>1/16</u>
Screen Type <u>N/C</u>	Depth to Bottom - Feet <u>235</u>	

DESCRIPTION OF FORMATIONS ENCOUNTERED	FROM	TO	FORMATIONS (continued)	
			FROM	TO
<u>Red Clay</u>	<u>0</u>	<u>20</u>		
<u>Red Sand</u>	<u>20</u>	<u>60</u>		
<u>White Blue Chalk</u>	<u>60</u>	<u>220</u>		
<u>Course Sand</u>	<u>220</u>	<u>235</u>		


RECEIVED
OCT 18 1993

Dept. of Environmental Quality
Office of Land & Water Resources

IF MORE SPACE IS NEEDED, USE BACK

If well telescopes please sketch and show depths.

GROUND LEVEL

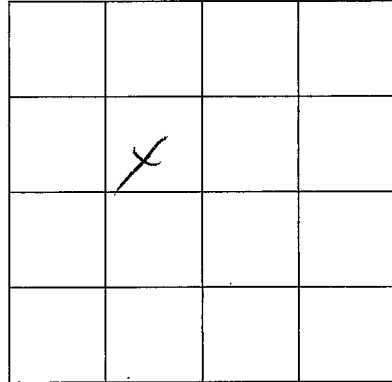

SECTION 35

Please indicate well location X.

ADDITIONAL INFORMATION

If more than one screen, show location of each on sketch.