

MISSISSIPPI DEPARTMENT OF NATURAL RESOURCES

Bureau of Land and Water Resources

Southport Mall

P.O. Box 10631

Jackson, Mississippi 39209

WATER WELL DRILLERS LOG

WILKINSON
N 0023

2/26/95
date well completed

Morphis Brothers
firm name

Wilkerson
county well located


LANDOWNER: Leroy Seiber
537 Seiber Lane
Woodville, Miss
(mailing address)

description of formations encountered	from	to
Med Sand & Gravel	0	20
Med Coarse Sand & Gravel	20	90
Brown Clay	90	120
Brown Clay	120	180
Brown & Red Clay	180	200
Med Coarse B. Sand w/ Red Clay	200	215
Coarse Med Sand	215	240

WELL LOCATION:
sec 27 T. 2 N S R. 1 E W
8 miles E of Woodville
(distance) (direction) (nearest town)

WELL PURPOSE: Home
(home, irrigation, municipal, industrial)

- WELL COMPLETION DATA:
- (1) diameter (inches) 4
 - (2) total depth (feet) 240
 - (3) static water level (feet) 80 ~~above~~ below top of ground.
 - (4) casing PVC, 200 (material) (depth)
4 (size) if telescope see back.
 - (5) screen 40 (length) (depth to top)
4, PVC, .020 (size) (material)
 - (6) pump (HP) (yield gpm)
(type power)
 - (7) electric log No (yes or no)
(organization running log)
 - (8) how well bottom plugged BWV

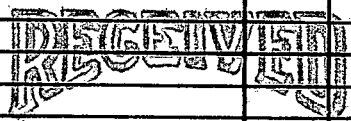


MAR 10 1995

DRILLERS REMARKS:

Dept. of Environmental Quality
Office of Land & Water Resources

If well telescopes please
sketch and show depths.

GROUND LEVEL

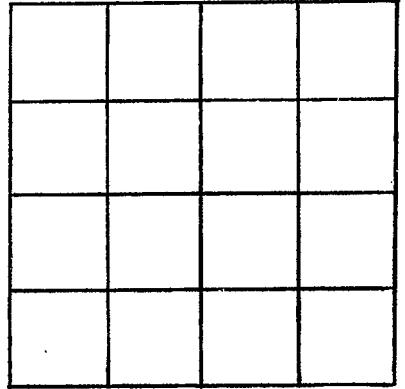

SECTION _____

Please indicate well location X.

ADDITIONAL INFORMATION

If more than one screen,
show locations of each on sketch.