

Wilkinson
08
9-5-69

MISSISSIPPI
 BOARD OF WATER COMMISSIONERS
 416 North State Street
 Jackson, Mississippi 39201

WATER WELL DRILLERS LOG

CODED
 Wilkinson
 County

9-5 19 69 Fitzgerald Well Drilling firm name Wilkinson county well located

LANDOWNER:
S. B. McKee III
RR Centerville, Miss.
 (mailing address)

description of formations encountered	from	to
<u>feol clay</u>	<u>0</u>	<u>20</u>
<u>feol sand</u>	<u>20</u>	<u>60</u>
<u>Red Brown</u>	<u>60</u>	<u>68</u>
<u>White clay</u>	<u>68</u>	<u>125</u>
<u>fine sand</u>	<u>125</u>	<u>145</u>
<u>Forest Course sand (under)</u>	<u>145</u>	<u>168</u>

WELL LOCATION:
 sec. 9 T 2 N R 1 E W
7 miles NW of Centerville
 (distance) (direction) (nearest town)

WELL PURPOSE: Home
 (home, irrigation, municipal, industrial)

- WELL COMPLETION DATA:
- (1) diameter (inches) 4
 - (2) total depth (feet) 168
 - (3) static water level (feet) 90 below above top of ground.
 - (4) casing plastic, 162
 (material) (depth)
4 if telescope see back.
 (size)
 - (5) screen 6, 162
 (length) (depth to top)
4, plastic
 (size) (material)
 - (6) pump 1/2, 12
 (HP) (yield gpm)
Elm
 (type power)
 - (7) electric log no
 (yes or no)
 (organization running log)
 - (8) how well bottom plugged wool


DRILLERS REMARKS:

CODED

CODED
 1969
 MISSISSIPPI
 BOARD OF WATER COMMISSIONERS
 JACKSON, MISSISSIPPI

If well telescopes please sketch and show depths.

GROUND LEVEL

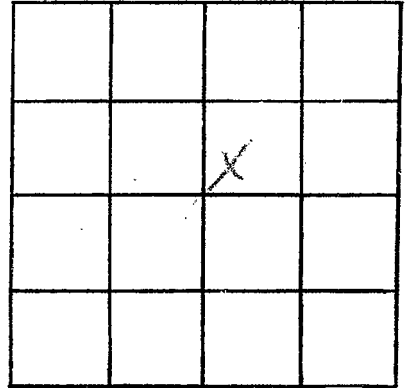

SECTION 9

Please indicate well location X.

ADDITIONAL INFORMATION

If more than one screen,
show locations of each on sketch.