

Wilkinson
09
7-8-69

MISSISSIPPI
 BOARD OF WATER COMMISSIONERS
 416 North State Street
 Jackson, Mississippi 39201

CODED

WATER WELL DRILLERS LOG

4/8 19 69 HERALDINGTON Wilkinson
 date well completed firm name county well located

LANDOWNER	description of formations encountered	from	to
<u>HARRY MOKEY JR.</u>	<u>clay</u>	<u>0</u>	<u>60'</u>
<u>RT-1 BOX 55A</u>	<u>sand & clay</u>	<u>60</u>	<u>105</u>
<u>CENTREVILLE, MISS</u>	<u>fine sand</u>	<u>105</u>	<u>120</u>
(mailing address)	<u>sand & gravel</u>	<u>120</u>	<u>150</u>

CODED

WELL LOCATION:
 ✓ sec. 34 1/2 T 2 N R 1 E
3 miles WEST of CENTREVILLE
 (distance) (direction) (nearest town)

✓ WELL PURPOSE: HOME
 (home, irrigation, municipal, industrial)

WELL COMPLETION DATA:

- (1) diameter (inches) 2"
- (2) total depth (feet) 142'
- (3) static water level (feet) 60' below above top of ground.
- (4) casing galv. 142
(material) (depth)

_____ if telescope see back.
 (size)

- (5) screen 5 _____
(length) (depth to top)

014 MORO
 (size) (material)

- (6) pump 1 set. 6
(HP) (yield gpm)

Electric
 (type power)

- (7) electric log NO
(yes or no)

 (organization running log)

- (8) how well bottom plugged BW valve


JAN
 16 1970

MISS. Bd. of
 WATER COM.

DRILLERS REMARKS:

If well telescopes please sketch and show depths.

GROUND LEVEL

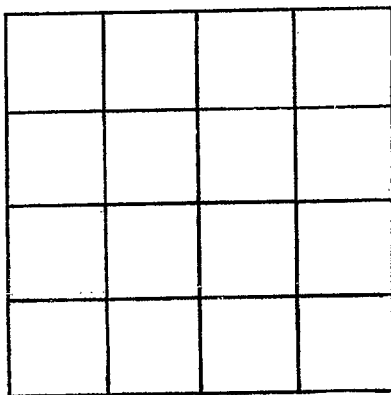

SECTION _____

Please indicate well location X.

ADDITIONAL INFORMATION

If more than one screen,
show locations of each on sketch.