

Wilkinson

Φ 10

1-2-70

MISSISSIPPI BOARD OF WATER COMMISSIONERS
416 North State Street
Jackson, Mississippi 39201

CODED

WATER WELL DRILLERS LOG

Jan 2 1970 date well completed
Reverwell Pump Co. firm name
Wilkinson county well located

LANDOWNER: Mrs. Barbara Baptist Church
Rt-1, Haster
(mailing address)

description of formations encountered	from	to
Red clay	0	17
Red sand	17	79
Small gravel	79	85
white chalk	85	160
Coars white sand	160	175

WELL LOCATION:
sec. 2 T. 2 N. R. 1 E
4 miles W SW of Glaston
(distance) (direction) (nearest town)

WELL PURPOSE:
(home, irrigation, municipal, industrial)

- WELL COMPLETION DATA:
- (1) diameter (inches) 4"
 - (2) total depth (feet) 175
 - (3) static water level (feet) 81 below top of ground.
 - (4) casing Plastic (material) Bottom (depth)
 - (size) if telescope see back.
 - (5) screen 6' (length) 175' (depth to top)
 - 4" (size) Plastic (material)
 - (6) pump 3/4 HP (HP) 6 (yield gpm)
 - Electric (type power)
 - (7) electric log NO (yes or no)
 - (organization running log)
 - (8) how well bottom plugged wooden plug


DRILLERS REMARKS:

FEB 24 1970

REC'D. DIV. OF
WATER CONTROL

If well telescopes please sketch and show depths.

GROUND LEVEL

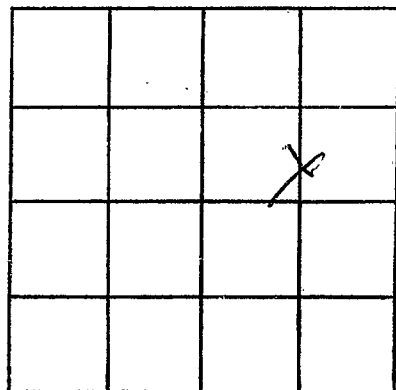

SECTION 2

Please indicate well location X.

ADDITIONAL INFORMATION

If more than one screen,
show locations of each on sketch.