

Wilkinson
 11
 2-23-70

MISSISSIPPI
 BOARD OF WATER COMMISSIONERS
 416 North State Street
 Jackson, Mississippi 39201

CODED

WATER WELL DRILLERS LOG

Feb 23 1970 Kernes Well Drilling Co. Wilkinson
 date well completed firm name county well located

LANDOWNER: John Taylor
 Rt. 1
 Clatter
 (mailing address)

description of formations encountered	from	to
Red clay	0	23
Red sand	23	90
Gravel sand	90	94
white chalk	94	185
fine blue sand	185	200
coarse sand	200	217

WELL LOCATION:
 sec. 2 T. 20 N. R. 1 E.
 4 miles WSW of Clatter
 (distance) (direction) (nearest town)

WELL PURPOSE: Home
 (home, irrigation, municipal, industrial)

WELL COMPLETION DATA:
 (1) diameter (inches) 4"
 (2) total depth (feet) 217
 (3) static water level (feet) 87 below top of ground.
 (4) casing (material) Plastic (depth) bottom
 (size) If telescope see back.
 (5) screen (length) 6' (depth to top)
 (size) 4' (material) Plastic
 (6) pump 1/2 sub 10 (HP) (yield gpm)
 (type power) elect.
 (7) electric log (yes or no) no
 (organization running log)

CODED

(8) how well bottom plugged
 water plug


MAR 23 1970

DRILLERS REMARKS:
 all well
 dry

MISS. BD. OF
 WATER COMM.

If well telescopes please sketch and show depths.

GROUND LEVEL

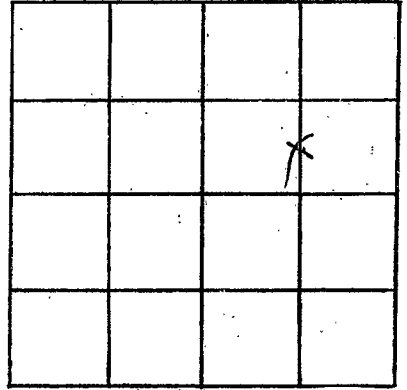

SECTION 2

Please indicate well location X.

ADDITIONAL INFORMATION

If more than one screen,
show locations of each on sketch.