

Wilkinson
 12
 4-13-70

MISSISSIPPI
 BOARD OF WATER COMMISSIONERS
 416 North State Street
 Jackson, Mississippi 39201

CODED

WATER WELL DRILLERS LOG

4/13 1970 Griner Water Well Wilkinson
 date well completed firm name county well located

LANDOWNER:
 Jimmy Dalton
 Centerville Miss
 (mailing address)

description of formations encountered	from	to
Top soil	0	2
Clay	2	42
fine Sand	42	49
Blue clay	49	136
Sand	136	175

WELL LOCATION:
 sec. 24 T. 2 N R. 1 E
 2 miles NW of Centerville
 (distance) (direction) (nearest town)

WELL PURPOSE: Home
 (home, irrigation, municipal, industrial)

- WELL COMPLETION DATA:
- (1) diameter (inches) 2"
 - (2) total depth (feet) 175'
 - (3) static water level (feet) 95' below top of ground.
 - (4) casing Galv 168' (material) (depth)
 2" (size) If telescope see back.
 - (5) screen 5' 168' (length) (depth to top)
 2" (size) 55 (material)
 - (6) pump 3 (HP) 86 gpm (yield gpm)
 elec. (type power)
 - (7) electric log No (yes or no)
 - (organization running log)
 - (8) how well bottom plugged Woodblock

CODED


APR 21 1970

DRILLERS REMARKS:

MISS. BD. OF
 WATER COMM.

If well telescopes please sketch and show depths.

GROUND LEVEL

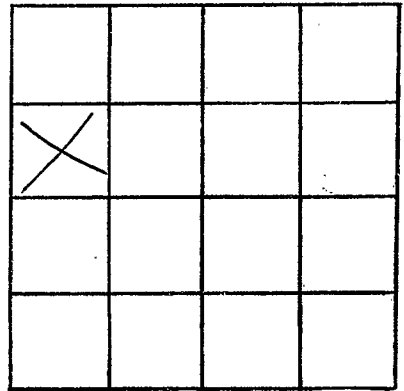

SECTION 24

Please indicate well location X.

ADDITIONAL INFORMATION

If more than one screen,
show locations of each on sketch.