

WILKINSON  
 § 13  
 10-2-70

MISSISSIPPI  
 BOARD OF WATER COMMISSIONERS  
 416 North State Street  
 Jackson, Mississippi 39201

**CODED**

WATER WELL DRILLERS LOG

10-2 1970 *Hanner Water Well Service Wilkinson*  
 date well completed firm name county well located

LANDOWNER:	description of formations encountered	from	to
<i>Andrew Spears</i>			
	<i>Clay</i>	<i>1</i>	<i>80</i>
	<i>Sand</i>	<i>80</i>	<i>135</i>
(mailing address)			
WELL LOCATION:			
sec. <i>37</i> T. <i>2</i> N. R. <i>1</i> E. S W			
<i>1 1/2</i> miles <i>west</i> of <i>Centerville</i> (distance) (direction) (nearest town)			
WELL PURPOSE: <i>Home</i> (home, irrigation, municipal, industrial)			
WELL COMPLETION DATA:			
(1) diameter (inches) <i>2"</i>			
(2) total depth (feet) <i>135'</i>			
(3) static water level (feet) <i>60'</i> below above top of ground.			
(4) casing <i>Galv.</i> <i>128'</i> (material) (depth) <i>2"</i> if telescope see back. (size)			
(5) screen <i>5'</i> <i>128'</i> (length) (depth to top) <i>2"</i> <i>SS</i> (size) (material)			
(6) pump <i>1</i> <i>6 GPM</i> (HP) (yield gpm) <i>elec.</i> (type power)			
(7) electric log <i>no</i> (yes or no)			
(organization running log)			
(8) how well bottom plugged <i>wood plug</i>			
DRILLERS REMARKS:			


**CODED**

OCT 29 1970

MISS. Bd. OF WATER COMMISSIONERS

If well telescopes please sketch and show depths.

GROUND LEVEL

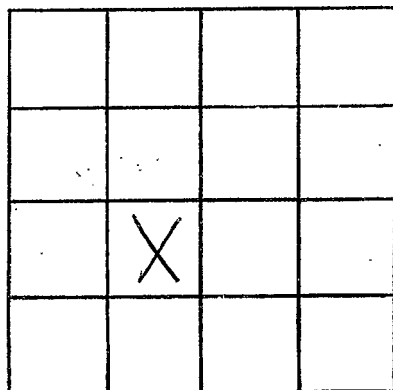

SECTION 37

Please indicate well location X.

ADDITIONAL INFORMATION

If more than one screen,  
show locations of each on sketch.