

WILKINSON  
 #14  
 11-11-70

MISSISSIPPI  
 BOARD OF WATER COMMISSIONERS  
 416 North State Street  
 Jackson, Mississippi 39201

**CODED**

FEB 19 1971

MISS. BD. OF  
 WATER COMM.

WATER WELL DRILLERS LOG

Nov. 11 1970 date well completed  
 Chester Rasmus Wilkinson firm name  
 county well located

LANDOWNER: Troy Mickey  
#1, Centerville  
 (mailing address)

description of formations encountered	from	to
sand & gravel	0	24
white chalk	24	72
sand & gravel	72	80

WELL LOCATION:  
 sec. 11 T. 2 N R. 1 E  
1/2 miles (distance) N (direction) Centerville (nearest town)

WELL PURPOSE: Home  
 (home, irrigation, municipal, industrial)

- WELL COMPLETION DATA:
- diameter (inches) 4"
  - total depth (feet) 80
  - static water level (feet) \_\_\_\_\_  
 top of ground. below / above
  - casing Plastic Bottom  
 (material) (depth)
  - screen 6' 74'  
 (length) (depth to top)  
1/2" Plastic  
 (size) (material)
  - pump 1/2 Sub 1 1/2  
 (HP) (yield gpm)  
elect  
 (type power)
  - electric log NO  
 (yes or no)
- (organization running log)


**CODED**

(8) how well bottom plugged?  
wooden plug

DRILLERS REMARKS:  
old 2" well had

If well telescopes please sketch and show depths.

GROUND LEVEL

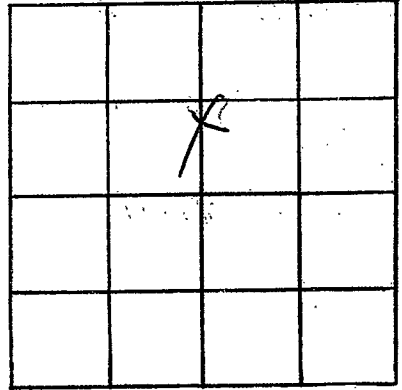

SECTION \_\_\_\_\_

Please indicate well location X.

ADDITIONAL INFORMATION

If more than one screen, show locations of each on sketch.